

Cowley

Map No. *Kane* Sec. *14* Twp. *30* R. *3*

Well No. 1 Tacabus Farm


Waite Phillips Company

Ft. from N. Line

330 Ft. from S. Line

Ft. from E. Line

330 Ft. from W. Line

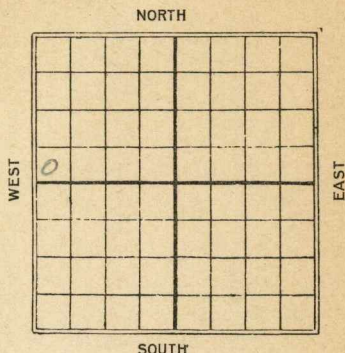

Beneat

Date _____

REPORT

31

P. O. G

6/5

Sl. 3290

6/30

Dec 9, 3565

KANSAS

Map No. Sec. 14 Twp. 30 R. 31

Well No. 1 Garden Farm

Warts Phillips Company

330' X 330' N

W

E

S

Location

Rig up

Drilling and Remarks

RECORD

Cased in. ft.

Sand

Gas

Oil

Total Depth

PRODUCTION

1st 24 hrs. Nat.

1st 24 hrs. after Shot

Gas cu. ft.

Dry Hole

Abandoned

Date 3/1 19 5

M. A. BENEAR Scout

12 **KANSAS** Map No. _____ Sec. 14 Twp. 30 R. 3E

Well No. 1 *Ja Carkus* _____
Waite Phillips Company

Contractor _____

ABANDONED SECTION PLAT

_____ Ft. from N. Line

330' _____ Ft. from S. Line

_____ Ft. from E. Line

330' _____ Ft. from W. Line

0			

Location _____

Rig up _____

Drilling and Remarks:

Tap. L. 30 88

10 + 9
3565'

RECORD

Cased _____ in., _____ ft.

Sand _____

Gas _____

Oil _____

Total Depth _____

PRODUCTION

1st 24 hrs. Nat. _____

1st 24 hrs. after shot _____

Gas _____ Cu. Ft.

Dry Hole _____

Abandoned _____

Date

JUN 30 1925

M. A. BENEAR

192

Scout

K12

MAP NO. **KANSAS** SEC. 14 TWP. 30S R. 3E

WELL NO. W Phillips

COMPANY

CONTRACTOR

SECTION PLAT

ABANDONED

FT. FROM N. LINE

FT. FROM S. LINE

FT. FROM E. LINE

FT. FROM W. LINE

RECORD

LOCATION

CASED IN. FT.

RIG UP

SAND

DRILLING AND REMARKS:

GAS

OIL

TOTAL DEPTH 3565

PRODUCTION

1ST 24 HRS. NAT.

1ST 24 HRS. AFTER SHOT

GAS Cu. Ft.

DRY HOLE

ABANDONED

DATE

4/17 1925

SCOUT