


KANSAS

Ellis county

Section 16 Township 13 Range 17-W

Well No. #1, Schmidt

Company The Texas Company

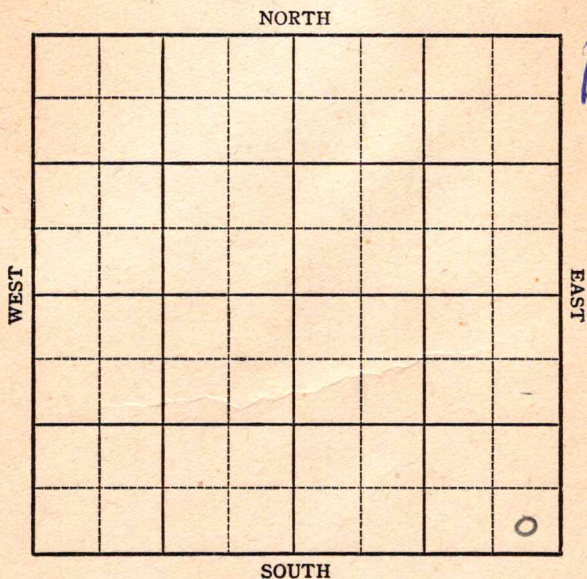

Sec. 16 Twp. 13 R. 17W

Well No. 1 Schmidt Farm
Texas Company


Sugar Loaf Pool

 Ft. from N. Line

330 Ft. from S. Line

330 Ft. from E. Line

 Ft. from W. Line

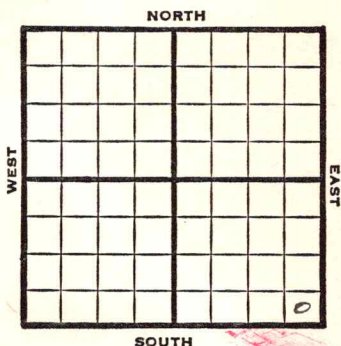

SE/C

1947 **Elev. 1976'** REPORT

1/8 Location

1/15 8" @ 4230
WOC

1/21 Drlg 3210'

1/30 **Lansing 3297**
Arb 3542
TD 3547'
5" @ 3545
RUST

2/5 TD 3556'
500 Acid
Swb 18 oil Ph 5 hrs

2/12 TD 3556'

2/19 Pump 57 bbls oil im 7 hrs

2/26 " " "

3/4 " " "

3/12 **Arb 3542'**
5" @ 3545
500 Acid
Pump 449 Pot
Grav. 28
TD 3556

COMPLETED

Map No. 71 Sec. 16 Twp. 13 R. 17W

Well No. 1 Schmidt

Texas


Company

FIRST REPORT

Contractor

SE/C

SECTION PLAT

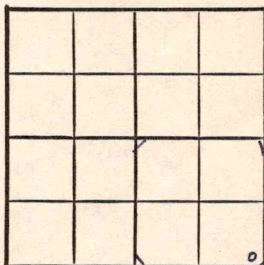

 Ft. from N. Line

330

 Ft. from S. Line

330

 Ft. from E. Line

 Ft. from W. Line

Ellis County

Location X

Rig up

Drilling and Remarks:

RECORD

Cased in., ft.

Sand

Gas

Oil

Total Depth

PRODUCTION

1st 24 hrs. Nat.

1st 24 hrs. after shot

Gas Cu. Ft.

Dry Hole

Abandoned

Date

JAN 8 1947 19

S. J. LEWIS Scout

Map No. 71 Sec. 16 Twp. 13 R. 17W

Well No. 1 Schmidt

Texas

Company


COMPLETE

Contractor

SE/C

E 11976

SECTION PLAT

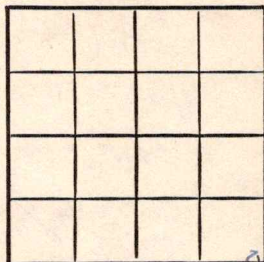

 Ft. from N. Line

330 Ft. from S. Line

330 Ft. from E. Line

 Ft. from W. Line

Ellis County

Location

Rig up

Drilling and Remarks:

Art 3542
5' 08545
500 acial
Pump 449 BX

252 46

RECORD

Cased in., ft.

Sand

Gas

Oil

Total Depth *2556*

PRODUCTION

1st 24 hrs. Nat.

1st 24 hrs. after shot

Gas Cu. Ft.

Dry Hole

Abandoned

Date

MAR 12 1947 19

S. J. LEWIS

Scout