


Cowley

KANSAS

Section 13 Township 30 Range 3-E

Well No. 1 Houser

Company Palmer Oil Corp.

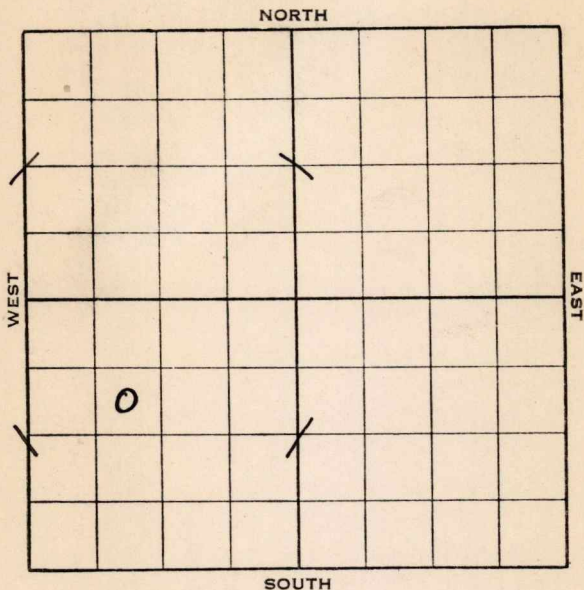

KANSAS

Cowley


Sec. 13 Twp. 30 R. 3-EWell No. #1 Houser Farm
Palmer Oil Corp. Company990 Ft. from N. Line

Ft. from S. Line

Ft. from E. Line

990 Ft. from W. Line

Elev. 1172

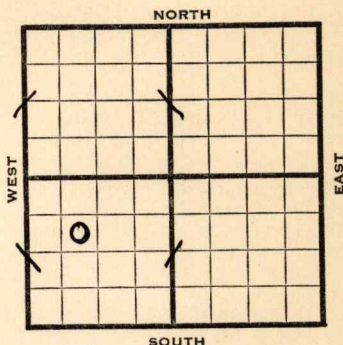

1938

REPORT

3/30 Drlg. 300'.

4/8 Drlg. 700'.

4/15 20" @ 85'. 15" @ 500'.

12" @ 1030'. Drlg. 1345'.

4/22 Drlg. 1735'.

4/29 10" @ 1730'. 8" @ 2270'.

K.C. 2330'. Drlg. 2340'.

5/6 Drlg. 2745'.

5/12 Drlg. 2930'.

5/20 SD3000'.

5/27 " "

6/3 " "

6/10 " "

6/15 7" @ 2997'.

Arb. 3254'.

T.D. 3258'.

H.F.W.

ABANDONED

Cowley

KANSAS

Map No. 12 Sec. 13 Twp. 30 R. 3EWell No. 1 HouserPalmer Oil Corp.

Company


Contractor

FIRST REPORT

SE NW SW

990 Ft. from N. Line Ft. from S. Line Ft. from E. Line990 Ft. from W. Line

SECTION PLAT

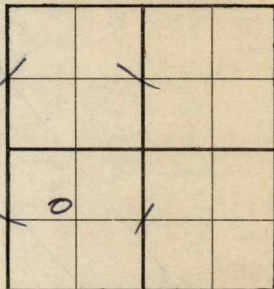Location Rig up

Drilling and Remarks:

Drlg. 300

RECORD

Cased in., ft.Sand Gas Oil Total Depth

PRODUCTION

1st 24 hrs. Nat. 1st 24 hrs. after shot Gas Cu. Ft.Dry Hole Abandoned

Date

MAR 30 193819H. D. Hatfield

Scout

Cowley **KANSAS**Map No. 12 Sec. 13 Twp. 30 R. 3EWell No. 1 HouserPalmer Oil Corp. Company

Contractor

ABANDONED

SE NW SW

990 Ft. from N. Line Ft. from S. Line Ft. from E. Line990 Ft. from W. Line

SECTION PLAT

Location Rig up

Drilling and Remarks:

HFW

D & A

RECORD

Cased 7 in., 2997 ft.Sand ARB 3254Gas Oil Total Depth 3258

PRODUCTION

1st 24 hrs. Nat. 1st 24 hrs. after shot Gas Cu. Ft.Dry Hole Abandoned

Date

JUN 15 1938 19

H. D. Hatfield

Scout