

Section 21 Township 17 Range 13 WWell No. # 9 SoderstromCompany P. E. Thayer

NORTH

7

				0			

SOUTH

WEST

EAST

Barton

KANSAS

Sec. 21 Twp. 17 R. 13 W

Well No. # 9 Soderstrom Farm

P. E. Thayer Company

Peel Contractor


Ft. from N. Line

990 Ft. from S. Line

Ft. from E. Line

330 Ft. from W. Line

NW SW NE

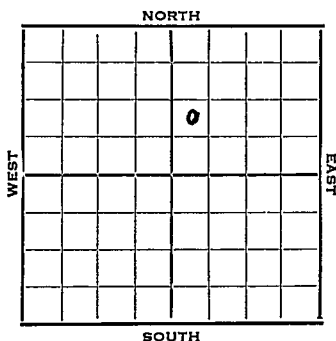


1952

Elev. 1971' REPORT

4/2 Spud 3031-52
8" @ 312' WOC
4/9 Anhy 905 Drlg. 3119'
4/23 CO Tools stuck.
4/30 Spud 3-31-52
Oil well TD 3447' 8" @ 312
Anhy 905' Lans. 3225' Arb. 3438'
TD 3447 5" @ 3438 CO to 3447
500 A
Comp. 35 BOPD 50% water.

COMPLETED

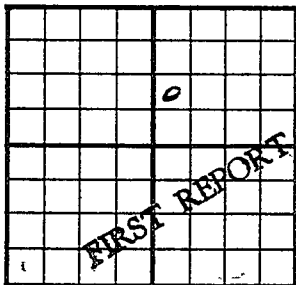County Barton State KansasSec. 21 (Blk. Twp.) 17 (Sur. Rge.) 13W Map No.Operator P. E. ThayerWell No. 9 Farm SoderstromElev. Location NW SW NE990 Ft. From S Line NE330 Ft. From W Line Quarter1st. Report APR 2 1952

Completion

Remarks

Peel - Contr.Spudding Date 3-31-52

Drlg. Data

8" @ 312 W.O.C.

J. G. McGEHEE

County Barton State KansasSec. 21 (Blk. Twp.) 17 (Sur. Rge.) 13W Map No.Operator P. E. ThayerWell No. 9 Farm SoderstromElev. 1971 Location NW SW NE

990 Ft. From S Line NE330 Ft. From W Line Quarter

1st. Report

Completion APR 30 1952

Remarks

Peel - Contr.Spudding Date 3-31-52Drlg. Data Oil well TD 34478" @ 312 Anhy 905 Lans. 3225Arb. 3438 TD 3447 5" @ 3438CO to 3447 500 A Comp. 35 bopd 50% wtr

J. G. McGEHEE