

Cowley


KANSAS

SECTION 16 TOWNSHIP 33 RANGE 3E

WELL NO. #5 Hunt

COMPANY Mead Production Co. (Tulsa)

NORTH NE NE SE

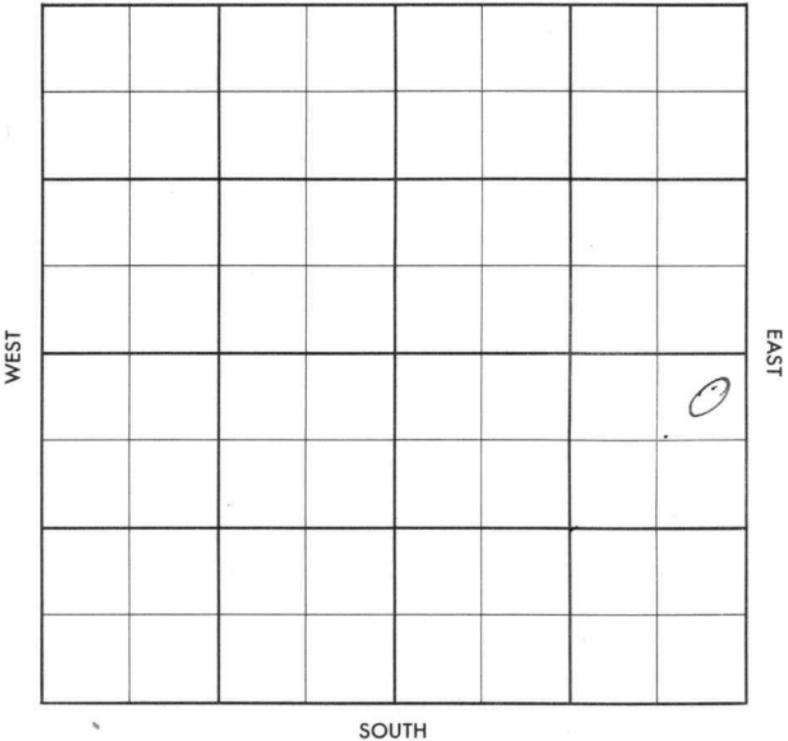

County Cowley Elev. _____
 Sec. 16 Twp. 33 Rge. 3E
 Company Mead Production Co. (Tulsa)
 FarmName Hunt No. 5

TOPS	DEPTH	LOG	DATUM
Anh.			
TP.			
H.			
Tr.			
Dg.			
BL.			
L.			
K.C.			
B.K.C.			
Ce.			
C.			
M.			
M.			
K.			
Mz.			
Me.			
V.			
S.			
S.			
A.			
R.			
PE.			
G.			
T.D.			

Loc. in Sec. NE NE SE
 Geol. _____
 Contr. _____
Ark Valley
 Pool _____
Rainbow Bend

FIRST REPORT
 MAY 8 57
 0

Date Comm. 4-28-57
8" @ 168/100, Drlg. 2679

~~2/19~~

Co.
 Lse.
 No.
 Sec.
 T.
 R.

County Cowley Elev. 1160
 Sec. 16 Twp. 33 Rge. 3E
 Company Lead Production Co. (Tulsa)
 Farm Name Hunt No. 5

TOPS	DEPTH	LOG	DATUM	Loc. in Sec.
Anb.				
Tp. <u>Staln</u>	<u>2225</u>			<u>NE NE SE</u>
H.				
Tr. <u>L24</u>	<u>2630</u>			
Dg.				
Bl.				
L.				<u>Boy Mead in</u>
K.C.	<u>2774</u>			<u>Geol. same material</u>
B.K.C.				<u>Cont.</u>
Ce. <u>Dart</u>	<u>3230</u>			<u>Ark Valley</u>
C.				
M. <u>chert</u>	<u>3250</u>			<u>Pool</u>
M.				
K.				<u>Rainbow Bend</u>
Mz.				
Mo.				
V.				
S.				
S.				
A.				
R.				
PE.				
G.				
T.D. <u>3264</u>	<u>3270</u>			

COMPLETE
 JUL 17 '57

Date Comm. 4-28-57
8" @ 168/100, Dr. 2679 MAY 15 '57 Pipe set
MAY 22 '57 MAY 29 '57 X 5 1/2 3260/125
Cable Tools over hole. JUN 5 '57 JUN 12 '57
JUN 19 '57 JUN 26 '57 JUL 3 '57 JUL 10 '57 JUL 17 '57

DD 3271 TD Frac Pop P. 35
Bopdt 4 BWPD P. 25 Bopd
+ 4 BWPD

no data