


Map No. **KANSAS** Sec. 21 Twp. 30 R. 3E
Well No. 1-Carlson Farm
Pyle-Sutter et al Company

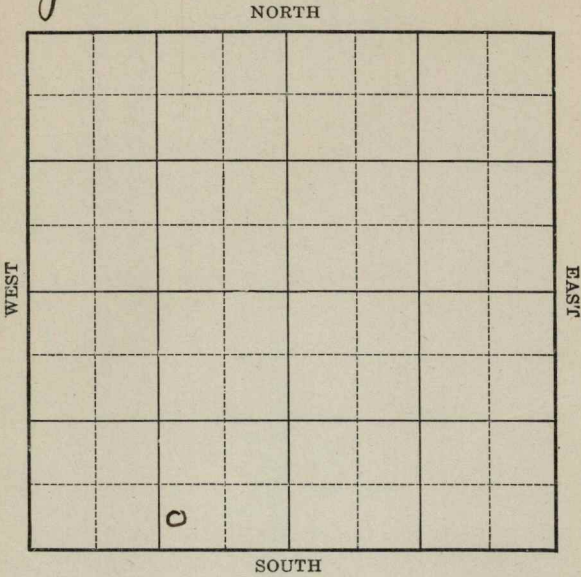

Location _____

Drilling Remarks _____

Rig Up _____

Drilling Remarks _____

RECORD


Cased _____ in. _____ ft.
Sand _____
Gas _____
Oil _____
Total Depth _____

PRODUCTION

1st 24 hrs. Nat. _____
1st 24 hrs. after shot _____
Gas _____ cu. ft.
Dry Hole _____
Abandoned _____

Map No. **KANSAS** Sec. 21 Twp. 30 R. 3EWell No. 1 - Carlson Farm
Pyle - Sutter et al Company

NORTH

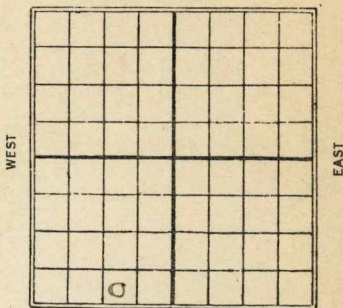

SOUTH

Ft. from N. Line

330 Ft. from S. Line1145 Ft. from E. Line

Ft. from W. Line

1928

Date

REPORT

3/28	R.O.G.
4/4	—
4/11	Rig + Tools
4/18	Spud 257-
4/25	Drlg 745
5/2	Run 10" @ 1465
5/9	T.D. 1910 - u.R. 8"
5/16	T.D. 2255 - u.R. 8"
5/23	Drlg 2395
5/31	" 3011
6/6	Spud 2995 - 3011-
	Top line 3093 - drlg 3130-
6/13	Drlg 3295-
6/20	" 3425
6/27	—
7/3	Wilcox 3549 - 55
	Pl line 3560 - T.D. 3564-
	H.F. W. - Shut down-
7/11	T.D. 3564 - 50.
7/18	T.D. 3564 u.R. A.

Map No. 12 **KANSAS** Sec. 21 Twp. 30 R. 3E

Well No. 1 Carlson

Pyle-Sutter & Co. Company

Contractor

SECTION PLAT

	0		

_____ Ft. from N. Line

330 Ft. from S. Line

1145 Ft. from E. Line

_____ Ft. from W. Line

FIRST REPORTS

Location _____

Rig up _____

Drilling and Remarks:

R.O.G.

RECORD

Cased _____ in., _____ ft.

Sand _____

Gas _____

Oil _____

Total Depth _____

PRODUCTION

1st 24 hrs. Nat. _____

1st 24 hrs. after shot _____

Gas _____ Cu. Ft.

Dry Hole _____

Abandoned _____

Date

MAR 28 1928

_____ 192_____

S. J. LEWIS

Scout

K12 **KANSAS**
 Map No. _____ Sec. 21 Twp. 30 R. 3E

Well No. 1 Carlson

Pyle-Sutter et al Company

Contractor

SECTION PLAT

_____ Ft. from N. Line

330 Ft. from S. Line

1145 Ft. from E. Line

_____ Ft. from W. Line

ABANDONED

Location _____

Rig up _____

Drilling and Remarks:

Total Depth.

3564

D & A

RECORD

Cased _____ in., _____ ft.

Sand _____

Gas _____

Oil _____

Total Depth _____

PRODUCTION

1st 24 hrs. Nat. _____

1st 24 hrs. after shot _____

Gas _____ Cu. Ft.

Dry Hole _____

Abandoned _____

Date

JUL 18 1928

S. J. LEWIS

Scout

K12

MAP No. **KANSAS** SEC. 21 TWP. 30S R. 3E

WELL No. 1 Carlson

Pyke-Sutter COMPANY

CONTRACTOR

SECTION PLAT

ABANDONED

_____ FT. FROM N. LINE

_____ FT. FROM S. LINE

_____ FT. FROM E. LINE

_____ FT. FROM W. LINE

LOCATION _____

RIG UP _____

DRILLING AND REMARKS:

mk

RECORD

CASED _____ IN. _____ FT.

SAND _____

GAS _____

OIL _____

TOTAL DEPTH 3564

PRODUCTION

1ST 24 HRS. NAT. _____

1ST 24 HRS. AFTER SHOT _____

GAS _____ CU. FT.

DRY HOLE ☒

ABANDONED ☒

DATE

7/3 1928 SCOUT