

Map No. M. Sec. 21 Twp. 30 R. 3E

Well No. 1 - Carlson Farm

Rotana Pet Corp. Company

NORTH

WEST

EAST

SOUTH

Location

Drilling Remarks

Rig Up

Drilling Remarks

RECORD

Cased in. ft.

Sand

Gas

Oil

Total Depth

PRODUCTION

1st 24 hrs. Nat.

1st 24 hrs. after shot

Gas cu. ft.


Dry Hole

Abandoned

Cowley

Map No. 15 Sec. 21 Twp. 30 R. 2 EWell No. 1 Carlson FarmRoxana Pet Corp Company

NORTH

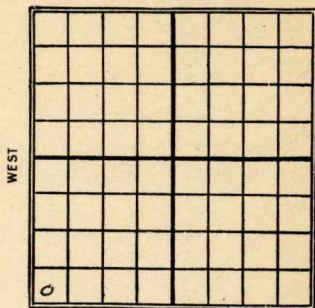

Ft. from N. Line

300 Ft. from S. Line

Ft. from E. Line

300 Ft. from W. Line1926

Date

REPORT

<u>11/16</u>	<u>Location</u>
<u>11/24</u>	<u>Same</u>
<u>12/1</u>	<u>—</u>
<u>12/8</u>	<u>—</u>
<u>12/15</u>	<u>Rog</u>
<u>12/21</u>	<u>Rig</u>
<u>12/29</u>	<u>Rigging up</u>
<u>1927</u>	
<u>1/5</u>	<u>Spud</u>
<u>1/12</u>	<u>Drilling 975</u>
<u>1/19</u>	<u>1295 fishing bailer</u>
<u>1/26</u>	<u>Drilling 1700</u>
<u>2/2</u>	<u>sand line 1825 to 34</u>
	<u>Show oil 1825 to 31 - Drlg 1870</u>
<u>2/9</u>	<u>Show oil 2060 to 75 - Drlg 2100</u>
<u>2/16</u>	<u>Drlg 2190</u>
<u>2/23</u>	<u>T. D. 2225 - Drlg up shoe</u>
<u>3/2</u>	<u>Drlg 2276</u>
<u>3/9</u>	<u>" 2550</u>
<u>3/16</u>	<u>Top line 2966 - oil 2966</u>
	<u>T. D. 2969 - 500' oil in 14</u>
	<u>hrs. - 6" hole</u>

- 3/23- Wilcox 2961-65 (S.L.M.)
20 bbls. 32.0 gravity oil - 24 hrs
- 3/30- Wilcox 2961 with oil
T.D. 2994 Sil. line - 130 bbl. 24 hrs
- 4/6- T.D. 2992 $\frac{1}{2}$ (S.L.M.)
Sil. line - 50 bbl oil - 120 water
- 4/13- water 2992 - Drlg 3016 H.F.W.
- 4/20- H.F.W. 3016 - T.D. 3064
will P.B. to 2992
- 4/27- P.B. to 2989 - W.O.C.S.
- 5/4- T.D. 2989 - waiting on cement to set
- 5/11- Plugging back to 2987-
- 5/18- Plugged back to 2979 - C.O.
- 5/25 —————
- 6/1 - Cem. 6" - 2989-
- 6/8 - T.D. 2989 - swabbing water
- 6/15 - T.D. 2989 - trying to make a well
- 6/22 —————
- 6/29 —————
- 7/6 - T.D. 2989 - U.R. 6"-
- 7/13 - T.D. 2989 - Cem. 6"-
- 7/20 - T.D. 2989 - W.O.C.S.
- 7/27 - T.D. 2989 - trying to shut off water.
- 8/3 - T.D. 3007 - U.R. 6"-
- 8/10 - Drlg 3016 -
- 8/17 - " 3076
- 8/24 - T.D. 3164 - S.D.
- 8/31 - T.D. 3164 L. & A.

12 **KANSAS**
 Map No. _____ Sec. 21 Twp. 30 R. 3E

Well No. 1 Carlson
Roxana Pet Corp. Company
 _____ Contractor

SECTION PLAT

_____ Ft. from N. Line

300 Ft. from S. Line

_____ Ft. from E. Line

300 Ft. from W. Line

FIRST REPORTS

0			

Location _____

Rig up _____

Drilling and Remarks:

Location.

RECORD

Cased _____ in., _____ ft.

Sand _____

Gas _____

Oil _____

Total Depth _____

PRODUCTION

1st 24 hrs. Nat. _____

1st 24 hrs. after shot _____

Gas _____ Cu. Ft.

Dry Hole _____

Abandoned _____

Date

NOV 17 1926

S. J. LEWIS

192

Scout

Country
K-12Map No. KANSAS Sec. 21 Twp. 30 R. 3EWell No. 1 CarbonRoxana P. & O. Corp. Company

Contractor

SECTION PLAT

0			

Ft. from N. Line

300 Ft. from S. Line

Ft. from E. Line

300 Ft. from W. Line

ABANDONED

Location

Rig up

Drilling and Remarks:

TJ 3164J & A

RECORD

Cased _____ in., _____ ft.

Sand _____

Gas _____

Oil _____

Total Depth _____

PRODUCTION

1st 24 hrs. Nat. _____

1st 24 hrs. after shot _____

Gas _____ Cu. Ft.

Dry Hole _____

Abandoned _____

Date

AUG 31 1927

S. J. LEWIS

Scout

MAP NO. K12 **KANSAS** SEC. 21 TWP. 30S R. 3E

WELL NO. 1 Carlson

Rohano COMPANY

CONTRACTOR

SECTION PLAT

ABANDONED

_____ FT. FROM N. LINE

_____ FT. FROM S. LINE

_____ FT. FROM E. LINE

_____ FT. FROM W. LINE

0			

LOCATION _____

RIG UP _____

DRILLING AND REMARKS:

RECORD

CASED _____ IN. _____ FT.

SAND _____

GAS _____

OIL _____

TOTAL DEPTH 316 ✓

PRODUCTION

1ST 24 HRS. NAT. _____

1ST 24 HRS. AFTER SHOT _____

GAS _____ CU. FT.

DRY HOLE ✓

ABANDONED ✓

DATE

8/30

192 7

SCOUT