


Section 21 Township 30 Range 3 E

Well No. # 1 Ammie Carlson

Company Greeley Drlg.

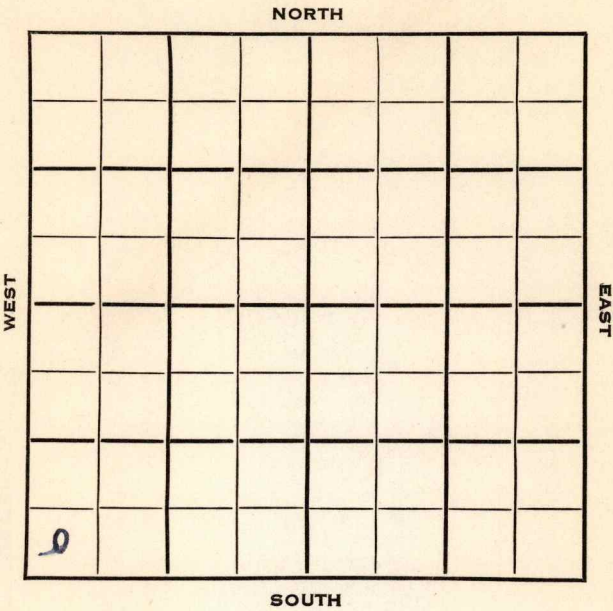

Cowley

KANSAS

Sec. 21 Twp. 30 R. 3 EWell No. # 1 Annie Carlson FarmGreeley Drlg.

Company

Contractor

Ft. from N. Line

330


Ft. from S. Line

Ft. from E. Line

330

Ft. from W. Line

SW SW SW

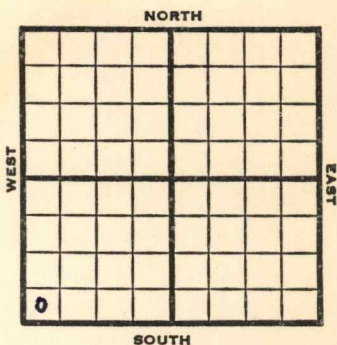

1953

Elev. 1259'

REPORT

8/5

Spud 8-1-53
8" @ 89

9/23

Spud 8-1-53

D & A TD 2120 8" @ 89

Tonkawa 2042' TD 2120 5" @ 2120

Hoover 1821 12/1826-30 9/1838-41

HFW D & A

ABANDONED

J. G. McGEHEE