

KANSAS


Form 51—5M—7-39—Palace

Cowley

Section 21 Township 30 Range 3-E

Well No. #1 Carlson

Company Sage, Murfin & Markey

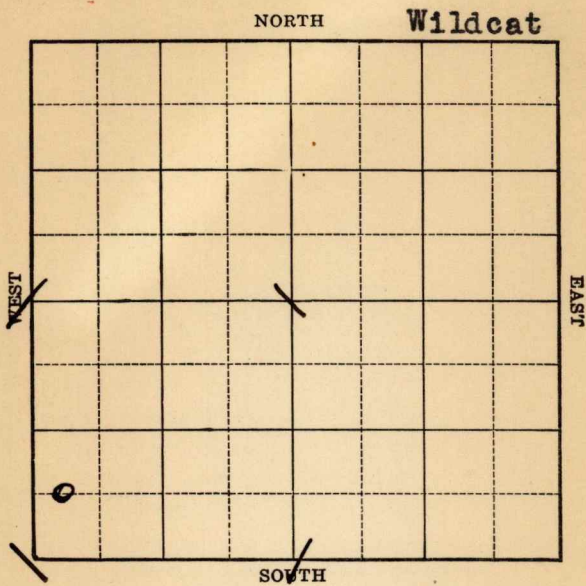

(Wildcat)


Ft. from N. Line

660 Ft. from S. Line

_____ Ft. from E. Line

330 Ft. from W. Line

Elev. 1260 Est DF
1257 GR

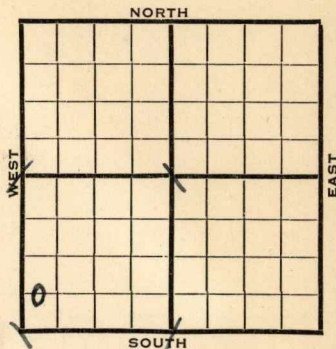

1940	REPORT
6/12	Cable.
6/20	"
6/27	"
7/3	"
7/11	Spud.
7/18	Drlg. 315'
7/25	12" - 608' Drlg. 1020'
8/2	12" - 661' Drlg. 1260'
8/8	10" - 1640' Drlg. 1816'
8/14	10" - 1837- Drlg. 1850'
8/22	8" - 2039' Stalnaker 2058'
	Water 2185' U.R. 8" - 2200'
8/29	8" - 2200' K.C. 2385'
	Drlg. 2425'
9/5	6" - 2565' SO 2910-25' T.D.
	C.O.
9/12	Miss. 3013' HFW 3015'
	T.D. 3020' 5" - 3020'
	Shut down.
	OVER

1940

9/18

Miss. 3013'

5" - 3020'

T.D. 3020'

H.F.W.

ABANDONED

KANSAS

Cowley

Map No. 12 Sec. 21 Twp. 30 R. 3EWell No. 1 CarlsonSage, Murfin & Markey Company

Contractor

FIRST REPORT


SECTION PLAT

C W L SW SW

Ft. from N. Line

660 Ft. from S. Line

Ft. from E. Line

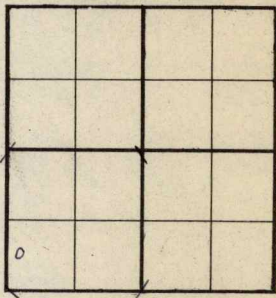330 Ft. from W. Line

WWILDCAT

Location _____

Rig up _____

Drilling and Remarks:

Cable

RECORD

Cased _____ in., _____ ft.

Sand _____

Gas _____

Oil _____

Total Depth _____

PRODUCTION

1st 24 hrs. Nat. _____

1st 24 hrs. after shot _____

Gas _____ Cu. Ft.

Dry Hole _____

Abandoned _____

Date

JUN 12 1940

19

S. J. LEWIS Scout

Map No. 12 Sec. 21 Twp. 30 R. 3E

Well No. 1 Carlson

Sage-Murfin-Markey Company

Contractor

ABANDONED

C W L SW SW

SECTION PLAT

 Ft. from N. Line

660 Ft. from S. Line

 Ft. from E. Line

330 Ft. from W. Line

WILDCAT

Location

Rig up

Drilling and Remarks:

Miss 3013

5" @ 3020

AFW.

RECORD

Cased in., ft.

Sand

Gas

Oil

Total Depth 3020

PRODUCTION

1st 24 hrs. Nat.

1st 24 hrs. after shot

Gas Cu. Ft.

Dry Hole

Abandoned

Date

SEP 18 1940

19

S. J. LEWIS

Scout