


Map No. KANSAS Sec. 16 Twp. 33 R. 2 ^E

Well No. R. J. W. Hunt Farm

Gypsy Oil Company

NORTH

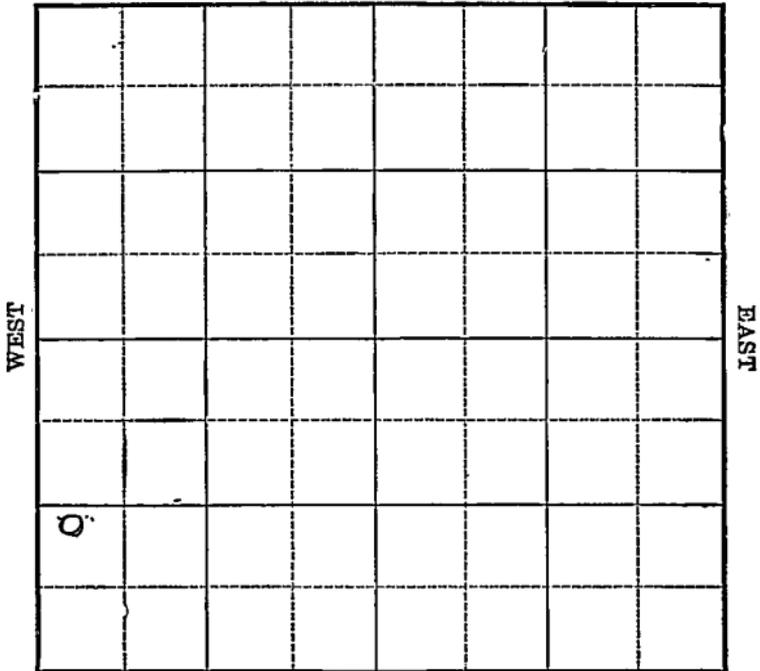

SOUTH

Location _____

Rig Up _____

Drilling Remarks:

Drilling Remarks:

RECORD

PRODUCTION

Cased _____ in. _____ ft.

1st 24 hrs. Nat. _____

Sand _____

1st 24 hrs. after shot _____

Gas _____

Gas _____ cu. ft.

Oil _____

Dry Hole _____

Total Depth _____

Abandoned _____

County *Cowley*
Map No. **KANSAS** Sec. *16* Twp. *33* R. *37*

Well No. *2 J. H. Hunt*

Gay Oil Company
Contractor

SECTION PLAT

1345 Ft. from N. Line
Ft. from S. Line
Ft. from E. Line
270 Ft. from W. Line

<i>0</i>			

FIRST REPORTS

Location _____
Rig up _____
Drilling and Remarks:

Spud.

RECORD

Cased _____ in., _____ ft.
Sand _____
Gas _____
Oil _____
Total Depth _____

PRODUCTION

1st 24 hrs. Nat. _____
1st 24 hrs. after shot _____
Gas _____ Cu. Ft.
Dry Hole _____
Abandoned _____

Date

JAN 13 1926

S. J. LEWIS

Scout

Map No. **KANSAS** Sec. 16 Twp. 33 R. 3E

Well No. 2 J. H. Hand

Gagey Oil Company

Contractor

SECTION PLAT

0			

1345 Ft. from N. Line

----- Ft. from S. Line

----- Ft. from E. Line

270 Ft. from W. Line

COMPLETED

Location -----

Rig up -----

Drilling and Remarks:

*W 83184.
W 83196
Shot 20 qts
35 lbs.*

RECORD

Cased ----- in., ----- ft.

Sand -----

Gas -----

Oil -----

Total Depth -----

PRODUCTION

1st 24 hrs. Nat. -----

1st 24 hrs. after shot -----

Gas ----- Cu. Ft.

Dry Hole -----

Abandoned -----

Date

MAY 12 1926 ₁₉₂

S. J. LEWIS

Scout