
Form 51 5M 8-24 16567

Map No. Kan Sec. 8 Twp. 12 R. 15 W

Well No. 23 Oswald Farm

Mid West Company

Stanolind Oil & G

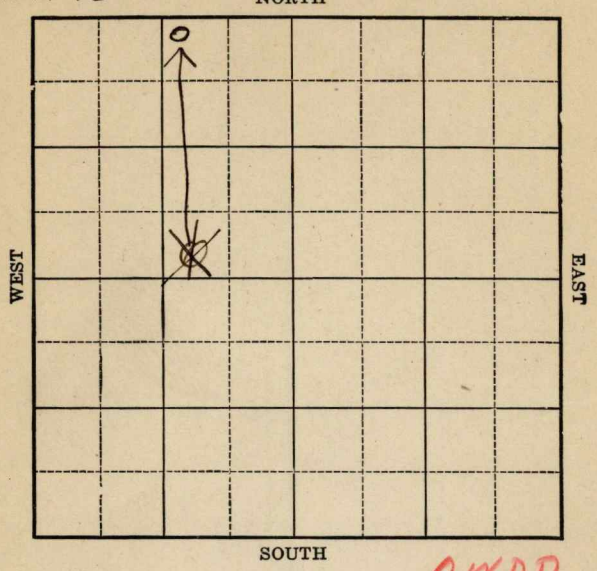

OWDD

Location	Rig Up
Drilling Remarks	Drilling Remarks

RECORD			PRODUCTION	
Cased	in.	ft.	1st 24 hrs. Nat.	
Sand			1st. 24 hrs. after shot	
Gas			Gas	cu. ft.
Oil			Dry Hole	
Total Depth			Abandoned	

Form 252A—5M—7-25—19684

Russell

Map No. Kansas Sec. 8 Twp. 12 R. 15 W

Well No. 3 Ed Oswald Farm


Mud-West Company

330 Ft. from N. Line

Ft. from S. Line

990 Ft. from E. Line

Ft. from W. Line

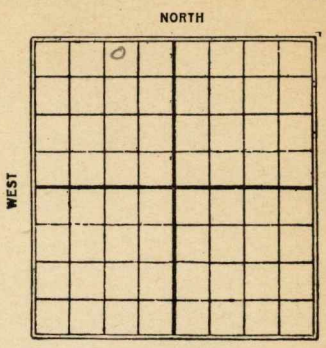

1st & Completed

Date	REPORT
11/25	
11/11	T 2919 B.S. 2929 Swabbed 200 Bbls 24 hours

Form 252A 5M 8-24 16529

Russell

Map No. Kan Sec. 8 Twp. 12 R 15 W

Well No. 3 Oswald Farm


~~Mid West~~ Stanolind Oil & Gas Company

330 Ft. from N. Line

~~330~~ 990 Ft. from S. Line

~~990~~ Ft. from E. Line

Ft. from W. Line

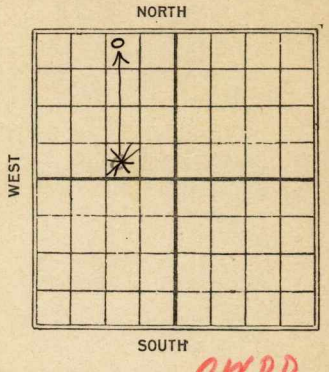

OWDD

Date	REPORT
1925	
6/9	5 MM Gas @ 2440
1926	
9/8	Lime 2919 - 2929
	Swabbed 200 bbls
1934	OWDD
7/11	Rgn to deepen
7/19	Dly 3040
7/26	CO 3065
8/2	Dly 3103 6" 2922
8/9	" 3131
8/16	SD 3131
8/23	3145 SD
8/30	6" 2922 Arnold 3141
	246' 5" liner 3143 S.O. 3160-65
9/6	Dly 3193
9/13	" 3250
9/20	3259 TD PB 3155 To acidize
9/27	No test
10/3	Arnold 3141 Oil 3160-65
	TD 3259 PB 3165 1000 acid
	45 oil 8 water

COMPLETED

Form 26-1M Bks.-3-23-1195 Plat Map

Map No. KANSAS Sec. 8 Twp. 12 R. 15 1


Well No. 3 Ed. Oswald

Mid-West Company

FIRST REPORTS Contractor

COMPLETED

SECTION PLAT

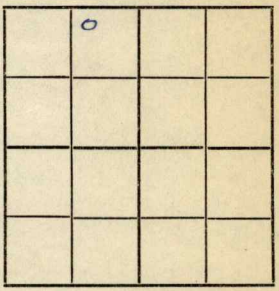

330 Ft. from N. Line

_____ Ft. from S. Line

990 Ft. from E. Line

_____ Ft. from W. Line

Location _____

Rig up _____

Drilling and Remarks:

TD 2919

DD 2929

Swabbed

200 BBLS - 24 Hrs

RECORD

Cased _____ in., _____ ft.

Sand _____

Gas _____

Oil _____

Total Depth _____

PRODUCTION

1st 24 hrs. Nat. _____

1st 24 hrs. after shot _____

Gas _____ Cu. Ft.

Dry Hole _____

Abandoned _____

Date

NOV 1 1 1925, 192

S. J. LEWIS Scout

Form 26—1M Bks.—3-23—11959.

Map No._____ Sec. 8 Twp. 12 R. 15W

Well No. 2 Oswald

Mid-West Company

_____ Contractor

FIRST REPORTS


_____Ft. from N. Line

330 Ft. from S. Line

990 Ft. from E. Line

_____Ft. from W. Line

SECTION PLAT

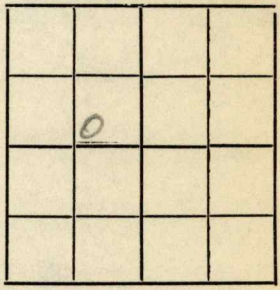

Location _____

Rig up _____

Drilling and Remarks:

5M Gas @ 2440

M R 8" to

2620'

RECORD

Cased_____in., _____ ft.

Sand _____

Gas _____

Oil _____

Total Depth_____

PRODUCTION

1st 24 hrs. Nat. _____

1st 24 hrs. after shot_____

Gas_____Cu. Ft.

Dry Hole_____

Abandoned_____

Date

6/9 1935 MMS

_____192____ _____Scout

Form 26—1M Bks.—3-23—11959.

Rotary
no map


Map No. KANSAS Sec. 8 Twp. 12 R. 15 W

Well No. 3 Conrad

Mid West Company

Contractor

SECTION PLAT

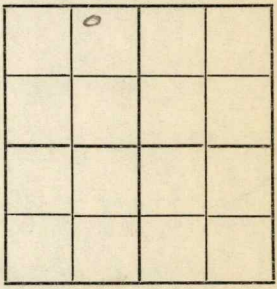

330 Ft. from N. Line

Ft. from S. Line

990 Ft. from E. Line

Ft. from W. Line

COMPLETED

Location

Rig up

Drilling and Remarks:

Sand 2919
To 2929

Swabbed
200 BFPH

RECORD

Cased in., ft.

Sand

Gas

Oil

Total Depth

PRODUCTION

1st 24 hrs. Nat.

1st 24 hrs. after shot

Gas Cu. Ft.

Dry Hole

Abandoned

Date

SEP 8 1926

192

S. J. LEWIS Scout

Form 26—1M Bks. 3-23—1959.

no map


Map No. KANSAS Sec. 8 Twp. 12 R. 15 W

Well No. 3 Oswalt

Mid-West Company

Contractor

SECTION PLAT

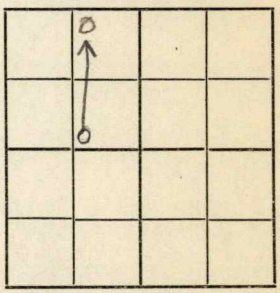

330 Ft. from N. Line

Ft. from S. Line

990 Ft. from E. Line

Ft. from W. Line

Correction

Location

Rig up

Drilling and Remarks:

Should be No 3 and not No 2. and 330 from N. and not 330 from S

RECORD

Cased in., ft.

Sand

Gas

Oil

Total Depth

PRODUCTION

1st 24 hrs. Nat.

1st 24 hrs. after shot

Gas Cu. Ft.

Dry Hole

Abandoned

Date

SEP 8 1926

192

S. J. LEWIS Scout

Form 26—IM Bks. 2-29

Russell

Map No. 72 Sec. 8 Twp. 12 R. 15W

Well No. 3 - Oswald

Standard O. & G. Company

Contractor

FIRST REPORTS


330 Ft. from N. Line

Ft. from S. Line

990 Ft. from E. Line

Ft. from W. Line

SECTION PLAT

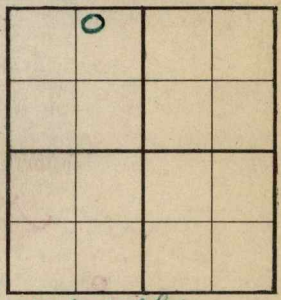

OWRD (Do not have record of old well)

Location

Rig up

Drilling and Remarks:

OTD 3024

Rig'n up

CORRECTION

Co. Name

RECORD

Cased in., ft.

Sand

Gas

Oil

Total Depth

PRODUCTION

1st 24 hrs. Nat.

1st 24 hrs. after shot

Gas Cu. Ft.

Dry Hole

Abandoned

Date

7-11-34 19

ORVAL MANNSCHRECK Scout

Form 26—1M Bks.—9-28

KANSAS

Map No. 77 Sec. 8 Twp. 13 R. 15W

Well No. 3- Oswald

Standard O & G. Company

Contractor

COMPLETED


330 Ft. from N. Line

Ft. from S. Line

990 Ft. from E. Line

Ft. from W. Line

SECTION PLAT

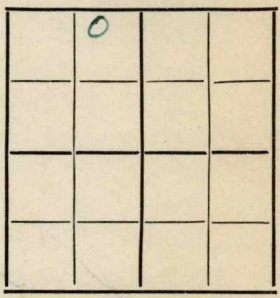

Location

Rig up

Drilling and Remarks:

P. B. 3165

1000 and

45 oil

8 water

RECORD

Cased in., ft.

Sand Oswald 3141

Gas

Oil 3160-65

Total Depth 3259

PRODUCTION

1st 24 hrs. Nat.

1st 24 hrs. after shot

Gas Cu. Ft.

Dry Hole

Abandoned

Date

10-3-34 192

ORVAL MANNSCHRECK Scout