


FORM 51 5M PETROL

Section 16 Township 33 Range 3E

Well No. 1 Schwantes

Company Branine and Hall etal

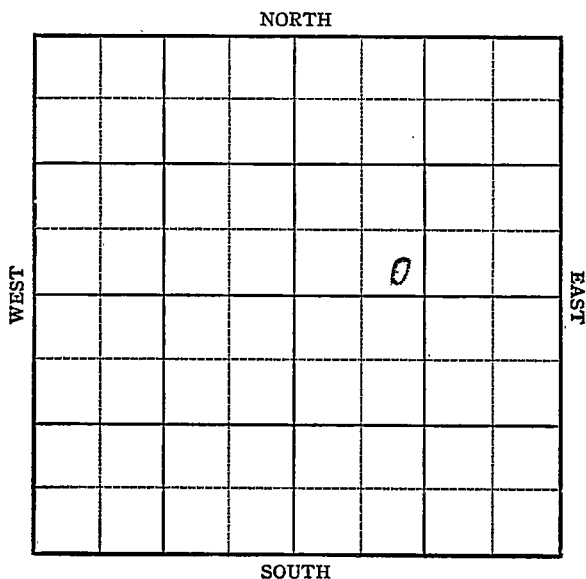

KANSAS

Cowley

Sec. 16 Twp. 33 R. 3E

Well No. 1 Schwantes Farm

~~Co-op et al~~ Branine & Hall et al Company


Miscellaneous

\_\_\_\_\_ Ft. from N. Line

330 Ft. from S. Line

\_\_\_\_\_ Ft. from E. Line

990 Ft. from W. Line

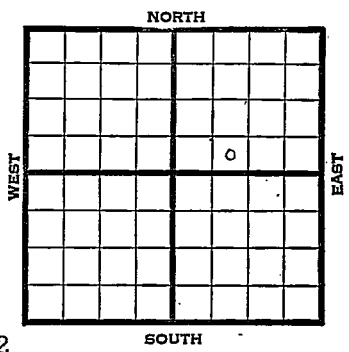

SE SW NE Elev. 1152

1945

REPORT

5/29

RUR

6/8

-10" @ 154 Drlg. 2240

6/20

Miss. 3221

TD 3238I

ABANDONED



Kansas Pool Name Miscellaneous

Map No. 7 Sec. 16 Twp. 33 R. 3E

Well No. 1 Schwantes

Branine and Hall et al Company

**CORRECTION**

Contractor

SE SW NE

SECTION PLAT

\_\_\_\_\_ Ft. from N. Line

330 Ft. from S. Line

\_\_\_\_\_ Ft. from E. Line

990 Ft. from W. Line


Cowley

Location \_\_\_\_\_

Rig up \_\_\_\_\_

Drilling and Remarks:

**reported  
Co-op et al**

**RECORD**

Cased \_\_\_\_\_ in., \_\_\_\_\_ ft.

Sand \_\_\_\_\_

Gas \_\_\_\_\_

Oil \_\_\_\_\_

Total Depth \_\_\_\_\_

**PRODUCTION**

1st 24 hrs. Nat. \_\_\_\_\_

1st 24 hrs. after shot \_\_\_\_\_

Gas \_\_\_\_\_ Cu. Ft.

Dry Hole \_\_\_\_\_

Abandoned \_\_\_\_\_

Date .

JUN 6 1945 19

S. J. LEWIS Scout

Kansas Pool Name Miscellaneous

Map No. \_\_\_\_\_ Sec. 16 Twp. 33 R. 3E

Well No. 1 Schwantes

Branine & Hall etal Company

**ABANDONED** Contractor

SE SW NE

*E 1152*  
SECTION PLAT


\_\_\_\_\_ Ft. from N. Line

330 Ft. from S. Line

\_\_\_\_\_ Ft. from E. Line

990 Ft. from W. Line

Cowley County

Location \_\_\_\_\_

Rig up \_\_\_\_\_

Drilling and Remarks:

*Misc 3221*

**RECORD**

Cased \_\_\_\_\_ in., \_\_\_\_\_ ft.

Sand \_\_\_\_\_

Gas \_\_\_\_\_

Oil \_\_\_\_\_

Total Depth 3238

**PRODUCTION**

1st 24 hrs. Nat. \_\_\_\_\_

1st 24 hrs. after shot \_\_\_\_\_

Gas \_\_\_\_\_ Cu. Ft.

Dry Hole \_\_\_\_\_

Abandoned \_\_\_\_\_

Date

JUN 20 1945 19

S. I. LEWIS Scout