


Section 16 Township 33 Range 3E

Well No. 1 Schwantes

Company Ben Gralapp et al
Wildcat

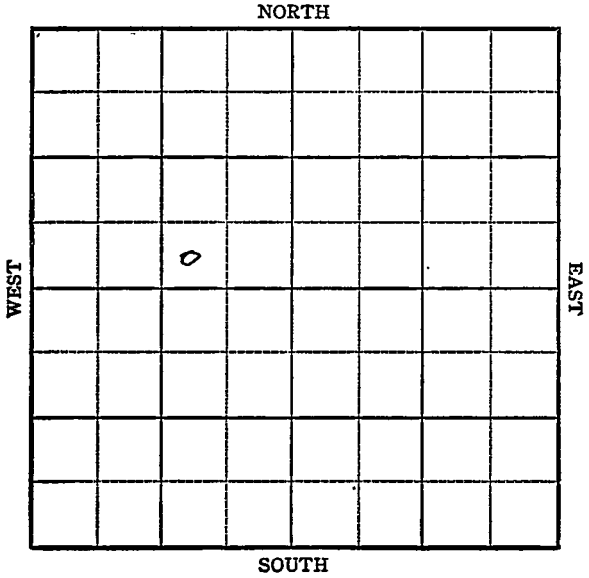

Sec. 16 Twp. 33 R. 3E ✓

Well No. 1 Schwantes Farm

Ben Gralapp et al Company

Wildcat


_____ Ft. from N. Line

330 Ft. from S. Line

990 Ft. from E. Line

_____ Ft. from W. Line

SW SE NW

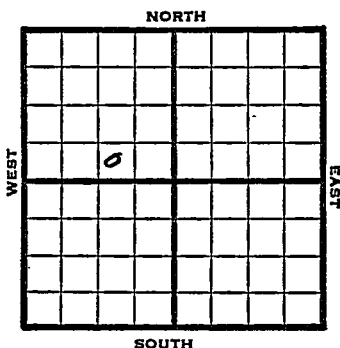

1948

Eli 1118'

REPORT

11/17

8" @ 92'

Drlg. 850'

11/23

KC 2560'

Drlg 2730'

12/1

TD 3182'

Miss 3177'

Aband.

ABANDONED

Map No. _____ Sec. 16 Twp. 33 R. 3E

Well No. 1 Schwantes

Ben Gralapp et al. Company

FIRST REPORT

Contractor

SW SE NW

SECTION PLAT

_____ Ft. from N. Line

330 Ft. from S. Line

990 Ft. from E. Line

_____ Ft. from W. Line

Cowley County

Location _____

Rig up _____

Drilling and Remarks:

8" @ 92

drlg. 850

RECORD

Cased _____ in., _____ ft.

Sand _____

Gas _____

Oil _____

Total Depth _____

PRODUCTION

1st 24 hrs. Nat. _____

1st 24 hrs. after shot _____

Gas _____ Cu. Ft.

Dry Hole _____

Abandoned _____

Date

NOV 17 1948

19

S. J. LEWIS Scout

Map No. / Sec. 16 Twp. 33 R. 3E

Well No. 1 Schwantes

Ben Gralapp et al. Company

ABANDONE! Contractor

SW SE NW

E1118
SECTION PLAT

 Ft. from N. Line

330 Ft. from S. Line

990 Ft. from E. Line

 Ft. from W. Line

Cowley County

Location

Rig up

Drilling and Remarks:

Miss 817?

RECORD

Cased in., ft.

Sand

Gas

Oil

Total Depth 817

PRODUCTION

1st 24 hrs. Nat.

1st 24 hrs. after shot

Gas Cu. Ft.

Dry Hole

Abandoned

Date

DEC 1 1948 19

S. J. LEWIS

Scout