


KANSAS

Section 21 Township 17 Range 13-W

Well No. #10 Soderstrom

Company Aladdin Pet.

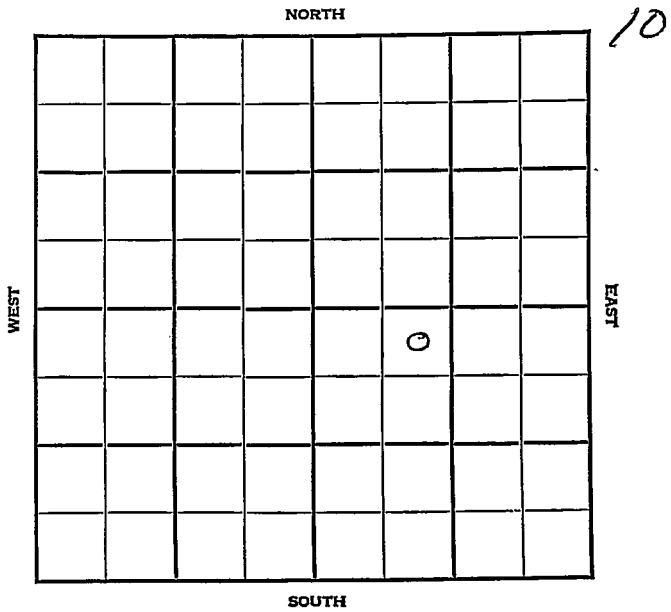

KANSAS

Barton



Sec. 21 Twp. 17 R. 13E

Well No. #10 Soderstrom Farm

Aladdin Pet. Company

Hosington Pool


330' Ft. from N. Line

\_\_\_\_\_ Ft. from S. Line

\_\_\_\_\_ Ft. from E. Line

990' Ft. from W. Line

NE NW SE

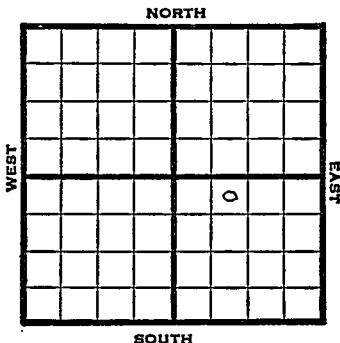

1948 Eli 1975' REPORT

6/30 RUR  
 7/8 8" @ 312'  
 Drlg 2475'  
 7/14 Arbuckle 3451-63'  
 TD 3463'  
 5" @ 3458'  
 7/21 Arb 3455' Corrected  
 TD 3463' 500 acid  
 150' oil 5 hrs.  
 7/28 1500 acid  
 8/4 "  
 8/11 "  
 8/18 Arb. 3455'  
 5" @ 3458'  
 TD 3463'  
 1500 acid  
 Pump 216 Oil / 29% W Pot.  
 36° Gr.  
 Comp

**COMPLETED**

Map No. \_\_\_\_\_ Sec. 21 Twp. 17 R. 13W

Well No. 10 Soderstrom

Aladdin Pet. \_\_\_\_\_ Company

**FIRST REPORT** \_\_\_\_\_ Contractor

NE NW SE

SECTION PLAT

330 Ft. from N. Line

\_\_\_\_\_ Ft. from S. Line

\_\_\_\_\_ Ft. from E. Line

990 Ft. from W. Line

		o	

Barton County

Location \_\_\_\_\_

Rig up \_\_\_\_\_

Drilling and Remarks:

R U R

RECORD

Cased \_\_\_\_\_ in., \_\_\_\_\_ ft.

Sand \_\_\_\_\_

Gas \_\_\_\_\_

Oil \_\_\_\_\_

Total Depth \_\_\_\_\_

PRODUCTION

1st 24 hrs. Nat. \_\_\_\_\_

1st 24 hrs. after shot \_\_\_\_\_

Gas \_\_\_\_\_ Cu. Ft.

Dry Hole \_\_\_\_\_

Abandoned \_\_\_\_\_

Date

JUN 30 1948 19

S. J. LEWIS Scout

Barton County Kansas State

Map No. 73 Sec. 21 Twp. 17 R. 13W

Well No. 10 Soderstrom

Aladdin Pet. Company

**COMPLETE**

Contractor

NE NW SE

E 11975  
SECTION PLAT

330 Ft. from N. Line

\_\_\_\_\_ Ft. from S. Line

\_\_\_\_\_ Ft. from E. Line

990 Ft. from W. Line

			0		

Hoisington Pool

Remarks:

*Cr 83455*

*5' 83454*

*7/1/3463*

*15-00 acid*

*Runy 216 oil 729% WOB*

*26% W*

Date

AUG 1 8 1948

Scout

S. J. LEWIS