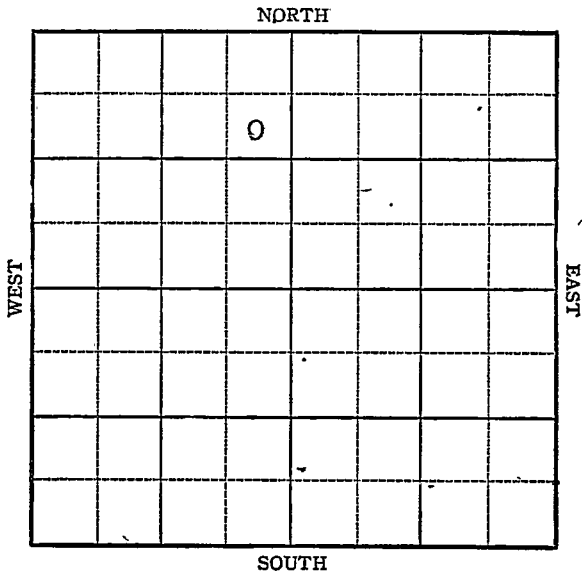


KANSAS

FORM 51 5M BR1X

Section 21 Township 17 Range 13WWell No. #1 Soderstrom "A"Company Kiowa Drlg.

KANSAS

Barton


Sec. 21 Twp. 17 R. 13W

Well No. #1 Soderstrom - "A" Farm
Kiowa Drlg.

Company

Ainsworth

NORTH

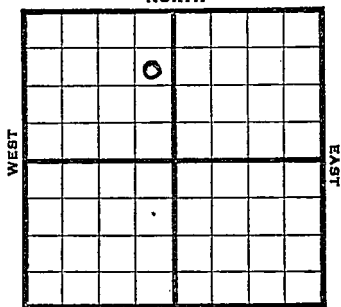

990 Ft. from N. Line

 Ft. from S. Line

330' Ft. from E. Line

 Ft. from W. Line

SE NE NW

Elev. 1975

SOUTH

1945

R E P O R T

1/24	10" - 350 Drlg 2100
1/31	Drlg. 3209
2/7	Arb 3456 TD 3462 7" @ 3459 RUST
2/14	TD 3488 SS0
2/21	PB 3270
2/28	Arb. 3456 7" @ 3459 TD 3488

ABANDONED

Pool Name AinsworthMap No. 73 Sec. 21 Twp. 17 R. 13WWell No. 1 SoderstromKiowa Drlg.


Company

FIRST REPORT

Contractor

SE NE NW

SECTION PLAT

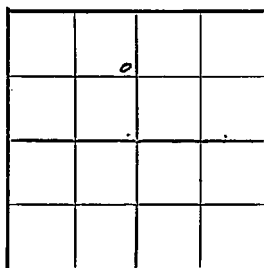990 Ft. from N. Line Ft. from S. Line330 Ft. from E. Line Ft. from W. LineBartonLocation Rig up

Drilling and Remarks:

10" - 3502100

RECORD

Cased in., ft.Sand Gas Oil Total Depth

PRODUCTION

1st 24 hrs. Nat. 1st 24 hrs. after shot Gas Cu. Ft.Dry Hole Abandoned

Date

JAN 24 1945 19S. J. LEWIS

Scout

Pool Name Ainsworth SouthMap No. K-73 Sec. 21 Twp. 17 R. 13WWell No. 1 Soderstrom "A"Kiowa Drilg. CompanyCORRECTION Contractor

SE NE NW

SECTION PLAT

990 Ft. from N. Line Ft. from S. Line330 Ft. from E. Line Ft. from W. Line

	o		

BartonLocation Rig up Drilling and Remarks:
reported as
#1 Soderstrom

RECORD

Cased in., ft.Sand Gas Oil Total Depth

PRODUCTION

1st 24 hrs. Nat. 1st 24 hrs. after shot Gas Cu. Ft.Dry Hole Abandoned

Date

FEB 14 1945 19S. J. LEWIS Scout

Pool Name AinsworthMap No. 73 Sec. 21 Twp. 17 R. 13WWell No. 1 Soderstrom "A"Kiowa Drlg.

Company

ABANDONED

Contractor

SE NE NW

SECTION PLAT

	6		

990 Ft. from N. Line Ft. from S. Line330 Ft. from E. Line Ft. from W. LineBarton CountyLocation Rig up

Drilling and Remarks:

CR 834567" CR 83459

RECORD

Cased in., ft.Sand Gas Oil Total Depth 3488

PRODUCTION

1st 24 hrs. Nat. 1st 24 hrs. after shot Gas Cu. Ft.Dry Hole Abandoned

Date

FEB. 28 1945

19

S. J. LEWIS

Scout