


Map No. Kansas Sec. 8 Twp. 12 R. 15<sup>W</sup>

Well No. 5 C Oswealf Farm  
Valerius Oil Company

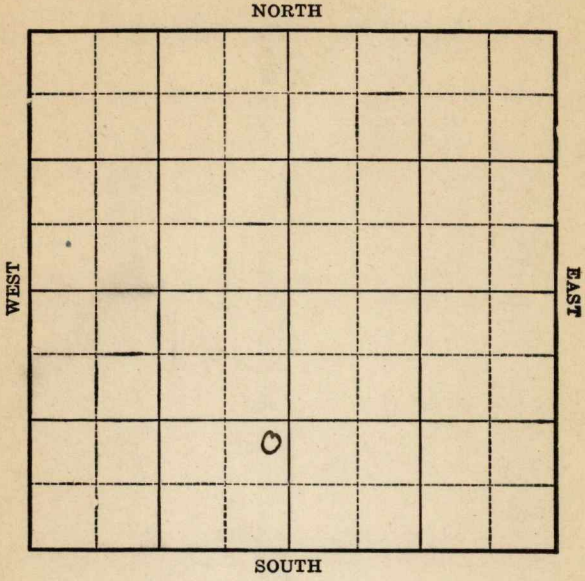

Location \_\_\_\_\_

Drilling Remarks:

\_\_\_\_\_

\_\_\_\_\_

**RECORD**

Cased \_\_\_\_\_ in. \_\_\_\_\_ ft.

Sand \_\_\_\_\_

Gas \_\_\_\_\_

Oil \_\_\_\_\_

Total Depth \_\_\_\_\_

Rig Up \_\_\_\_\_

Drilling Remarks:

\_\_\_\_\_

\_\_\_\_\_

**PRODUCTION**

1st 24 hrs. Nat. \_\_\_\_\_

1st 24 hrs. after shot \_\_\_\_\_

Gas \_\_\_\_\_ cu. ft.

Dry Hole \_\_\_\_\_

Abandoned \_\_\_\_\_



Map No. **KANSAS** Sec. 8 Twp. 12 R. 15W

Well No. 5 E. Oswald

Valerious O + G. Company

Contractor

**FIRST REPORT**

----- Ft. from N. Line

990' Ft. from S. Line

330' Ft. from E. Line

----- Ft. from W. Line

**SECTION PLAT**

	0		

Location -----

Rig up -----

Drilling and Remarks:

0. 920'

**RECORD**

Cased ----- in., ----- ft.

Sand -----

Gas -----

Oil -----

Total Depth -----

**PRODUCTION**

1st 24 hrs. Nat. -----

1st 24 hrs. after shot -----

Gas ----- Cu. Ft.

Dry Hole -----

Abandoned -----

Date **APR 23 1925**

----- 192-----

**M. A. BENEAR**

Scout

Map No. \_\_\_\_\_ Sec. 8 Twp. 12 R. 13W

Well No. 5 Oswald

Valerius Company

Contractor

**COMPLETED**

**SECTION PLAT**

\_\_\_\_\_ Ft. from N. Line

990' Ft. from S. Line

330' Ft. from E. Line

\_\_\_\_\_ Ft. from W. Line

	0		

Location \_\_\_\_\_

Rig up \_\_\_\_\_

Drilling and Remarks:

*Pay 2959-67  
swapping 250 lbs*

**RECORD**

Cased \_\_\_\_\_ in., \_\_\_\_\_ ft.

Sand \_\_\_\_\_

Gas \_\_\_\_\_

Oil \_\_\_\_\_

Total Depth \_\_\_\_\_

**PRODUCTION**

1st 24 hrs. Nat. \_\_\_\_\_

1st 24 hrs. after shot \_\_\_\_\_

Gas \_\_\_\_\_ Cu. Ft.

Dry Hole \_\_\_\_\_

Abandoned \_\_\_\_\_

Date

6/9 1925

Scout