


Russell

Map No. Kaw Sec. 8 Twp. 12 R. 15^W

Well No. 4- Farm

Mid-West Ref. Co. Company

NORTH

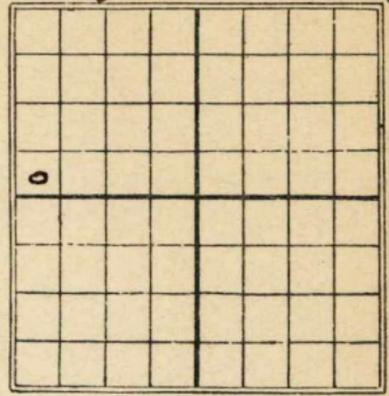

..... Ft. from N. Line

300 Ft. from S. Line

..... Ft. from E. Line

300 Ft. from W. Line

B

Date
1925

REPORT

<u>6/30</u>	<u>Rig up</u>
<u>7/9</u>	<u>\$ 2916</u> <u>Oil and 2923</u> <u>100 Bbls</u>

Russell
12 R. 15 W

Map No. **KANSAS** Sec. 8 Twp. 12 R. 15 W

Well No. #4

Mid-West Ref Company

Contractor

FIRST REPORT

SECTION PLAT

_____ Ft. from N. Line

300 Ft. from S. Line

_____ Ft. from E. Line


300 Ft. from W. Line

o			

Location _____

Rig up ✓✓

Drilling and Remarks:

 

RECORD

Cased _____ in., _____ ft.
 Sand _____
 Gas _____
 Oil _____
 Total Depth _____

PRODUCTION

1st 24 hrs. Nat. _____
 1st 24 hrs. after shot _____
 Gas _____ Cu. Ft.
 Dry Hole _____
 Abandoned _____

Date JUN 30 1925

M. A. BENEAR

Russell

Map No. **KANSAS** Sec. 8 Twp. 12 R. 15

Well No. 4 *This should be 31*

Mid-West Company

Contractor

SECTION PLAT

0			

----- Ft. from N. Line

300 Ft. from S. Line

----- Ft. from E. Line

300 Ft. from W. Line

COMPLETED

Location -----

Rig up -----

Drilling and Remarks:

MS 2916
BS 2923

100 ft

RECORD

Cased ----- in., ----- ft.

Sand -----

Gas -----

Oil -----

Total Depth -----

PRODUCTION

1st 24 hrs. Nat. -----

1st 24 hrs. after shot -----

Gas ----- Cu. Ft.

Dry Hole -----

Abandoned -----

Date

SEP 9 1935

S. J. LEWIS

Scout