

Cowley


KANSAS

SECTION 16 TOWNSHIP 33S RANGE 3E

WELL NO. #1 Schwantes

COMPANY Glen Drlg.

NORTH App. SE SW NE

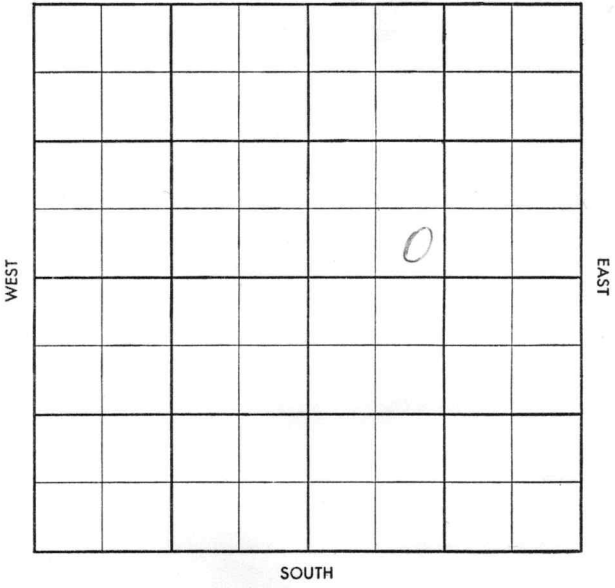



CO. ~~Cowley~~ ELEV. 1153.00

SEC. 16 TWP. 33 RGE. 3E

COMPANY ~~Glen Drlg.~~ NO. 1

CO.  
NO.  
SEC. 18 57  
ABANDONED

FARM Schwantes TWIN WELL

LOC. APP SE SW NE 100' N


GEOL. \_\_\_\_\_  
 CONTR. Co; Tools  
 POOL Graham  
 SPUD 11/16/57  
 8" @ 150, Drlg. 925  
 7054  
 END 3209-17  
 550 M 3224-2071  
 550 TD 3229  
 5" 3229 WOL

DEC 4 57 DD 327/TD 550  
 LOT W PB 3227 40/3216-26  
 50 250A \$ AWSO  
 DEC 18 57 for \$ LD + W  
 no new oil

DDA

CO.  
NO.  
SEC.  
TWP.  
RGE.