
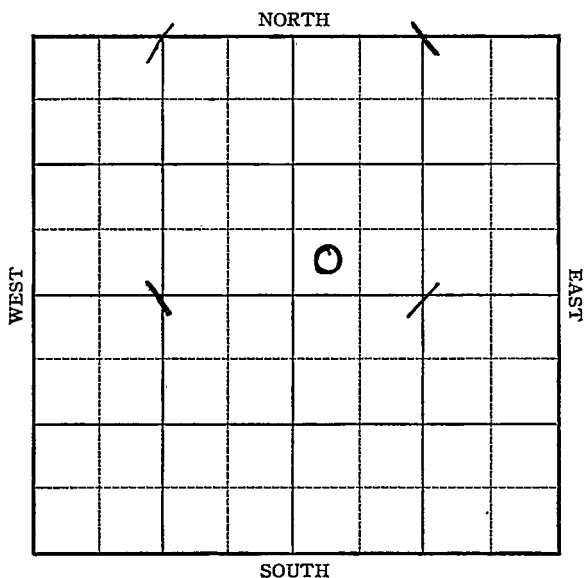


Section 16 Township 33 Range 3-EWell No. 1 - SchwantesCompany Pryor & Lockhart et al

Pryor & Lockhart et al Company

330 Ft. from W. Line

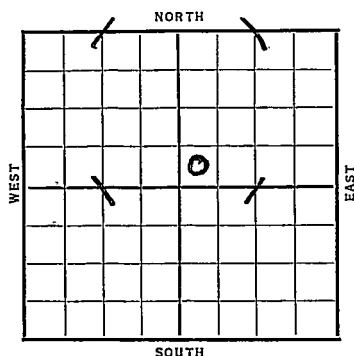

Date	REPORT
1937	
6/9	Location
6/19	"
6/25	Cable rig.
7/2	" "
7/9	" "
7/16	R. U.
7/23	20" @ 40'. Drlg. 300'.
7/30	15" @ 578'. SD 880' Repairs.
8/6	T.D. 1304' S.D.
8/13	12" @ 1304'. Drlg. 1700'.
8/20	10" @ 1753'. 8" @ 2200'.
	Drlg. 2230'.
8/28	8" @ 2405'. Drlg. 2525'.
9/3	T.D. 2725' SD.
9/10	6" @ 2722'. S.O. & G 2765-70'.
	T.D. 2820' U.R.
	OVER

1937
9/15

6" @ 2800'
Hart 3180-92'
Chat 3192-96'
Miss 3196'
TD 3217'
S.O. 3184-3190'
No water
D&A

ABANDONED

Map No. 1 Sec. 16 Twp. 33 R. 3EWell No. 1 SchwantesPryor & Lockhart et al Company

Contractor

FIRST REPORT

SECTION PLAT

_____ Ft. from N. Line

330 Ft. from S. Line

_____ Ft. from E. Line

330 Ft. from W. LineLocation ✓

Rig up _____

Drilling and Remarks:

RECORD

Cased _____ in., _____ ft.

Sand _____

Gas _____

Oil _____

Total Depth _____

PRODUCTION

1st 24 hrs. Nat. _____

1st 24 hrs. after shot _____

Gas _____ Cu. Ft.

Dry Hole _____

Abandoned _____

Date

JUN 9 1937

H. D. Hatfield Scout

Cowley KANSAS

Map No. 1 Sec. 16 Twp. 33 R. 3EWell No. 1-Schwantes
Pryor & Lockhart et al Company

Contractor

ABANDONED

SECTION PLAT

		0	

_____ Ft. from N. Line

330 Ft. from S. Line

_____ Ft. from E. Line

330 Ft. from W. Line

Location _____

Rig up _____

Drilling and Remarks:

Bart 3180-92Chat 3192-96S.O. 3184 & 3190NO WATERD & A

RECORD

Cased 6 in., 2800 ft.Sand MISS 3196

Gas _____

Oil _____

Total Depth 3217

A. J. PRODUCTION

1st 24 hrs. Nat. _____

1st 24 hrs. after shot _____

Gas _____ Cu. Ft.

Dry Hole _____

Abandoned _____

Date

SEP 15 1937 19

H. D. Hatfield

Scout