


Map No. Kansas Sec. 8 Twp. 12 R. 15^W

Well No. 4 Oswald Farm

Stearns, Streeter & Yankee Company

NORTH

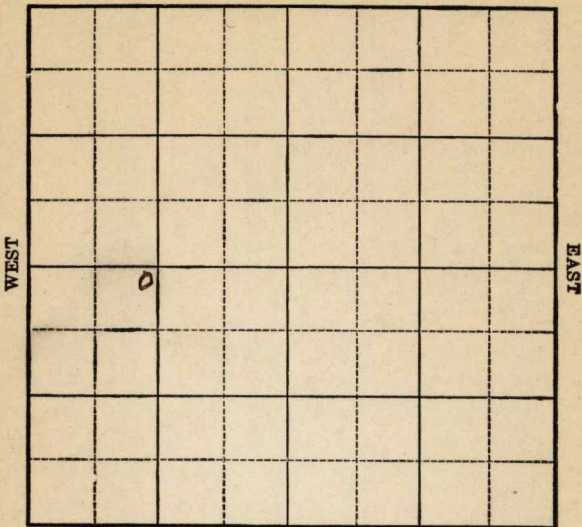

SOUTH

Location _____

Rig Up _____

Drilling Remarks:

Drilling Remarks:

RECORD

PRODUCTION

Cased _____ in. _____ ft.

1st 24 hrs. Nat. _____

Sand _____

1st 24 hrs. after shot _____

Gas _____

Gas _____ cu. ft.

Oil _____

Dry Hole _____

Total Depth _____

Abandoned _____

Map No. *Kansas* Sec. *8* Twp. *12* R. *15^W*


Well No. *4 Oswald* Farm
Stearns Street + Yankee Company

330 Ft. from N. Line

..... Ft. from S. Line

..... Ft. from E. Line

990 Ft. from W. Line

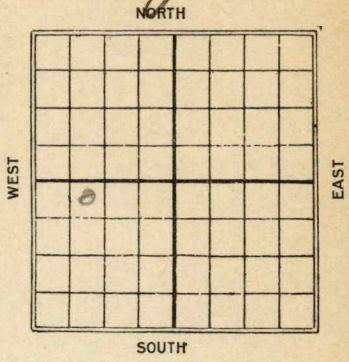

B

Date

REPORT

1925

4/28 Rig up

6/2 900

9/9 2721 Btm Sand 2738

450 Bbb

Map No. **KANSAS** Sec. *8* Twp. *12* R. *15W*

Well No. *4 Oswald*

Sturms Street & Yankee Company

Contractor

FIRST REPORT

SECTION PLAT

330 Ft. from N. Line

----- Ft. from S. Line

----- Ft. from E. Line

990 Ft. from W. Line

o			

Location -----

Rig up *✓ ✓* -----

Drilling and Remarks:

RECORD

Cased ----- in., ----- ft.

Sand -----

Gas -----

Oil -----

Total Depth -----

PRODUCTION

1st 24 hrs. Nat. -----

1st 24 hrs. after shot -----

Gas ----- Cu. Ft.

Dry Hole -----

Abandoned -----

Date

APR 28 1925

M. A. BENEAR

----- 192

----- Scout

Russell

Map No. **KAUSAS** Sec. *8* Twp. *12* R. *15 W*

Well No. *4 Oswald*

Sterns Street & Yorks Company
Contractor

SECTION PLAT

330 Ft. from N. Line
----- Ft. from S. Line
----- Ft. from E. Line
990 Ft. from W. Line

0			

COMPLETED

Location -----

Rig up -----

Drilling and Remarks:

TS 2731
BS 2738
4508 1/2

RECORD

Cased ----- in., ----- ft.
Sand -----
Gas -----
Oil -----
Total Depth -----

PRODUCTION

1st 24 hrs. Nat. -----
1st 24 hrs. after shot -----
Gas ----- Cu. Ft.
Dry Hole -----
Abandoned -----

Date

SEP 9 1925
----- 192-----

S. J. LEWIS

Scout