


Map No. Kansas Sec. 8 Twp. 12 R. 15^W

Well No. 4 Oswald Farm _____
Valerius Oil. Company _____

NORTH

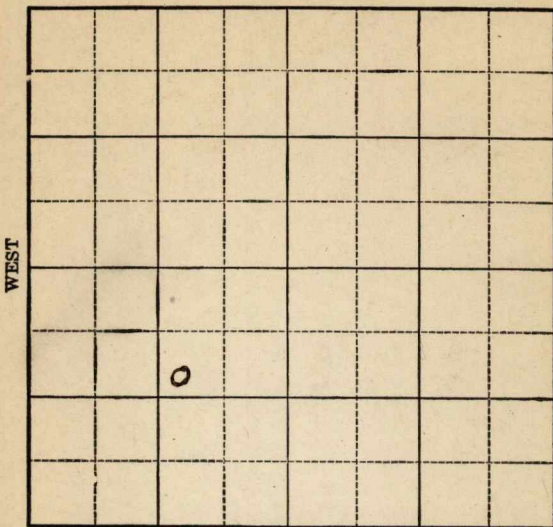

SOUTH

Location _____

Drilling Remarks:

Rig Up _____

Drilling Remarks:

RECORD

Cased _____ in. _____ ft.

Sand _____

Gas _____

Oil _____

Total Depth _____

PRODUCTION

1st 24 hrs. Nat. _____

1st 24 hrs. after shot _____

Gas _____ cu. ft.

Dry Hole _____

Abandoned _____

Map No. _____ Sec. 8 Twp. 12 R. 15W

Well No. H. E. Oswald

Valerius Company

Contractor

SECTION PLAT

COMPLETED

1020 Ft. from N. Line

_____ Ft. from S. Line

1020 Ft. from E. Line

_____ Ft. from W. Line

	0		

Location _____

Rig up _____

Drilling and Remarks:

Pay 2935-39
pumping
250 lbs

RECORD

Cased _____ in., _____ ft.

Sand _____

Gas _____

Oil _____

Total Depth _____

PRODUCTION

1st 24 hrs. Nat. _____

1st 24 hrs. after shot _____

Gas _____ Cu. Ft.

Dry Hole _____

Abandoned _____

Date

6/9 192

[Signature] Scout

Russell

Map No. **KANSAS** Sec. 8 Twp. 12 R. 15W

Well No. 4 Oswald
Valerius O & G. Company

Contractor

FIRST REPORT

SECTION PLAT

1020' Ft. from N. Line

----- Ft. from S. Line

1020' Ft. from E. Line

----- Ft. from W. Line

	0		

Location -----

Rig up -----

Drilling and Remarks:

D. 1540'

RECORD

Cased ----- in., ----- ft.

Sand -----

Gas -----

Oil -----

Total Depth -----

PRODUCTION

1st 24 hrs. Nat. -----

1st 24 hrs. after shot -----

Gas ----- Cu. Ft.

Dry Hole -----

Abandoned -----

Date

APR 23 1925

M. A. BENEAR

----- 192-----

----- Scout