


Map No. Rams 8 Sec. 8 Twp. 12 R. 15^W
 Well No. 5 Oswald Farm
Streeter & Stearns Company

NORTH

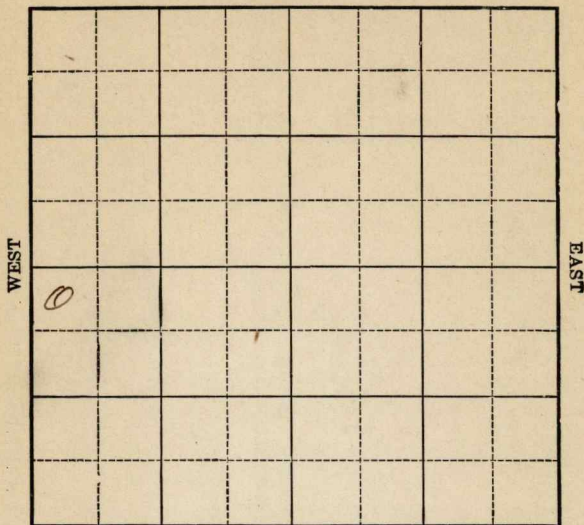

SOUTH

Location _____

Drilling Remarks _____

Rig Up _____

Drilling Remarks _____

RECORD

Cased _____ in. _____ ft.

Sand _____

Gas _____

Oil _____

Total Depth _____

PRODUCTION

1st 24 hrs. Nat. _____

1st. 24 hrs. after shot _____

Gas _____ cu. ft.

Dry Hole _____

Abandoned _____

Russell


Map No. Kan. Sec. 8 Twp. 12 R 15WWell No. 5 Oswald FarmStreeter & Stearns Company330 Ft. from N. Line

Ft. from S. Line

Ft. from E. Line

330 Ft. from W. Line

B

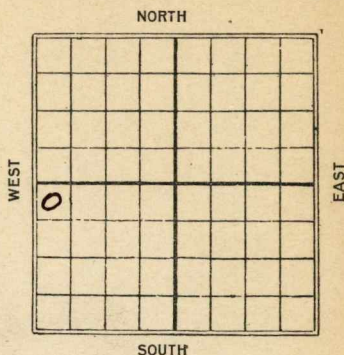Date
1925

REPORT

6/30

Rig up

9/1

\$ 2914 Btm Sand

2920 250 Bbls

KANSASMap No. _____ Sec. 8 Twp. 12 R. 15WWell No. 5 OswaldStrutts & Stearns Company_____
Contractor**FIRST REPORT****SECTION PLAT**330 Ft. from N. Line

_____ Ft. from S. Line

_____ Ft. from E. Line

330 Ft. from W. Line

0			

Location _____

Rig up ✓✓

Drilling and Remarks:

RECORD

Cased _____ in., _____ ft.

Sand _____

Gas _____

Oil _____

Total Depth _____

PRODUCTION

1st 24 hrs. Nat. _____

1st 24 hrs. after shot _____

Gas _____ Cu. Ft.

Dry Hole _____

Abandoned _____

Date

JUN 30 1925

M. A. BENEAR

192

Scout

Map No. Russell **KANSAS** Sec. 8 Twp. 12 R. 15WWell No. 5 OswaldStreeter & Sterns Company

Contractor

SECTION PLAT

330 Ft. from N. Line

Ft. from S. Line

Ft. from E. Line

330 Ft. from W. Line

0			

COMPLETED

Location

Rig up

Drilling and Remarks:

MS 2914BS 2920250 ft

RECORD

Cased _____ in., _____ ft.

Sand _____

Gas _____

Oil _____

Total Depth _____

PRODUCTION

1st 24 hrs. Nat. _____

1st 24 hrs. after shot _____

Gas _____ Cu. Ft.

Dry Hole _____

Abandoned _____

Date

SEP 9

1920

S. J. LEWIS

Scout