


Map No. Kansas Sec. 8 Twp. 12 R. 15^W

Well No. 6. Oswald Farm _____
Valerius etal Company _____

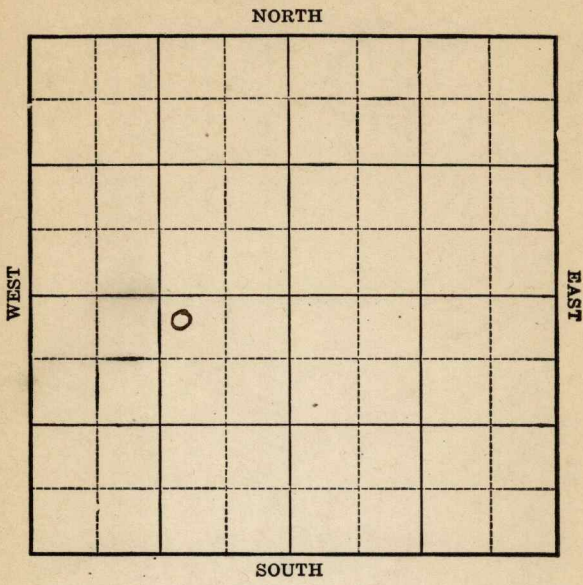

Location _____

Rig Up _____

Drilling Remarks:

Drilling Remarks:

RECORD

PRODUCTION

Cased _____ in. _____ ft.

Sand _____

Gas _____

Oil _____

Total Depth _____

1st 24 hrs. Nat. _____

1st 24 hrs. after shot _____

Gas _____ cu. ft.

Dry Hole _____

Abandoned _____

Map No. **KANSAS** Sec. 8 Twp. 12 R. 15W

Well No. 6 Oswald

Valerius et al. Company

Contractor

FIRST REPORT

SECTION PLAT

330 Ft. from N. Line

_____ Ft. from S. Line

990 Ft. from E. Line

_____ Ft. from W. Line

	0		

Location _____

Rig up _____

Drilling and Remarks:

spudding.

RECORD

Cased _____ in., _____ ft.

Sand _____

Gas _____

Oil _____

Total Depth _____

PRODUCTION

1st 24 hrs. Nat. _____

1st 24 hrs. after shot _____

Gas _____ Cu. Ft.

Dry Hole _____

Abandoned _____

Date

APR 23 1925

M. A. BENEAR

_____ 192_____

Scout

Russell

Map No. KANSAS Sec. 8 Twp. 12 R. 15 W

Well No. 6 Oswald

Vaterious Oil Company

Contractor

SECTION PLAT

330 Ft. from N. Line

----- Ft. from S. Line

990 Ft. from E. Line

----- Ft. from W. Line

	0		

COMPLETED

Location -----

Rig up -----

Drilling and Remarks:

TS 2933

BS 2944

275 ft

RECORD

Cased ----- in., ----- ft.

Sand -----

Gas -----

Oil -----

Total Depth -----

PRODUCTION

1st 24 hrs. Nat. -----

1st 24 hrs. after shot -----

Gas ----- Cu. Ft.

Dry Hole -----

Abandoned -----

Date

SEP 9 - 1925

S. J. LEWIS

Scout