

Section 21 Township 17 Range 13W

Well No. #5 Soderstrom "B"

Company Ferrier Drlg. etal.

NORTH

8

						0	

WEST

EAST

SOUTH

KANSAS

Barton

Sec. 21 Twp. 17 R. 13W ✓

Well No. #5 Soderstrom "B" Farm

Ferrier Drlg. et al Company

Hoisington Pool


_____ Ft. from N. Line

330' Ft. from S. Line

990' Ft. from E. Line

_____ Ft. from W. Line

SW SE NE

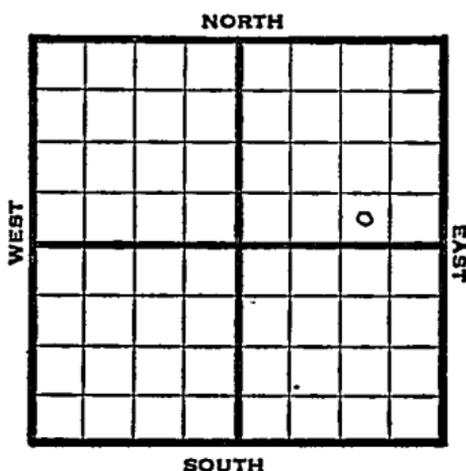

1948 Eli 1986' REPORT

- 5/12 Derrick
- 5/19 8" @ 360'
Drlg. 2775'
- 5/26 Arbuckle 3453'
Run 5"
- 6/1 5" @ 3454'
TD 3473'
500 Acid
- 6/9 Swb 8 bbls Oil PH
- 6/15 "
- 6/28 "
- 6/29 "
- 7/8 "
- 7/14 "
- 7/21 "
- 7/28 "
- 8/4 "
- 8/11 "
- 8/18 "
- 8/25 Arb. 3453'
5" @ 3454'
TD 3473'
500 acid

Pump 263 oil 6% W Pot
360 Gr. Comp **COMPLETED**

Map No. _____ Sec. 21 Twp. 17 R. 13W

Well No. 5 Soderstrom "B"

Ferrier Drlg. etal. Company

FIRST REPORT

Contractor.

SW SE NE

SECTION PLAT

_____ Ft. from N. Line

330 Ft. from S. Line

990 Ft. from E. Line

_____ Ft. from W. Line

			o

Barton County

Location _____

Rig up _____

Drilling and Remarks:

Derrick

RECORD

Cased _____ in., _____ ft.

Sand _____

Gas _____

Oil _____

Total Depth _____

PRODUCTION

1st 24 hrs. Nat. _____

1st 24 hrs. after shot _____

Gas _____ Cu. Ft.

Dry Hole _____

Abandoned _____

Date

MAY 12 1948 19

S. J. LEWIS Scout

Barton County Kansas State

Map No. 73 Sec. 21 Twp. 17 R. 13W

Well No. 5 Soderstrom "B"

Ferrier Drlg. etal. Company

COMPLETE

Contractor

SW SE NE

E. 1986
SECTION PLAT

 Ft. from N. Line

330 Ft. from S. Line

990 Ft. from E. Line

 Ft. from W. Line

Hoisington Pool
Remarks:

CR 3453

5" @ 3454

7023423

500 acid

Run 26 Soil + 6% W/B

36 2/3

Date
AUG 25 1948

Scout
S. J. LEWIS