

KANSAS

Barton

Section 22 ~ Township 17 Range 13WWell No. #3 BogerCompany Derby et al

NORTH

13

SOUTH

WEST

EAST

②

KANSAS

Barton

Sec. 22 Twp. 17 R. 13W

Well No. #3 Boger Farm

Derby et al

Company

Susank


 Ft. from N. Line

990 Ft. from S. Line

 Ft. from E. Line

330 Ft. from W. Line

NW SW SW

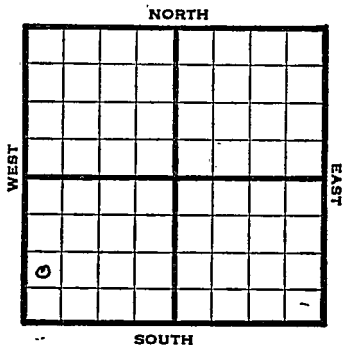

1947 Elev. 1902' REPORT

12/3 8" @ 330'
Drlg. 2645'

12/10 Lansing 3043'
Arbuckle 3364'
TD 3367'
5" @ 3366'
RUST

12/23 Arb. 3364'
5" @ 3366'
Pump 250 Pot
39.0 Gr.
TD 3370'

COMPLETED

Map No. _____ Sec. 22 Twp. 17 R. 13W

Well No. 3 Boger

Derby et al. Company

FIRST REPORT Contractor

NW SW SW

SECTION PLAT

_____ Ft. from N. Line

990 Ft. from S. Line

_____ Ft. from E. Line

330 Ft. from W. Line

o			

Barton County

Location _____

Rig up _____

Drilling and Remarks:

8" @ 330

drlg. 2645

RECORD

Cased _____ in., _____ ft.

Sand _____

Gas _____

Oil _____

Total Depth _____

PRODUCTION

1st 24 hrs. Nat. _____

1st 24 hrs. after shot _____

Gas _____ Cu. Ft.

Dry Hole _____

Abandoned _____

Date

DEC 3 1947 19

S. J. LEWIS

Scout

Map No. K 73 Sec. 22 Twp. 17 R. 13W

Well No. 3 Boger

Derby etal. Company

COMPLETE

Contractor

NW SW SW


E 11902
SECTION PLAT

 Ft. from N. Line

990 Ft. from S. Line

 Ft. from E. Line

330 Ft. from W. Line

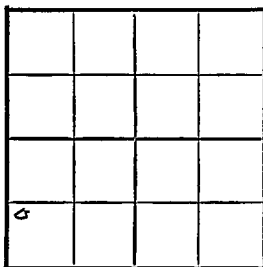

Barton County

Location

Rig up

Drilling and Remarks:

CR 83364

5" @ 3366

Open 2500 ft

379 ft

RECORD

Cased in., ft.

Sand

Gas

Oil

Total Depth 3370

PRODUCTION

1st 24 hrs. Nat.

1st 24 hrs. after shot

Gas Cu. Ft.

Dry Hole

Abandoned

Date

DEC 23 1947

19

S. I. LEWIS Scout