


Section 16 Township 13 Range 17-W

Well No. #4 F. A. Schmidt

Company Texas Co.

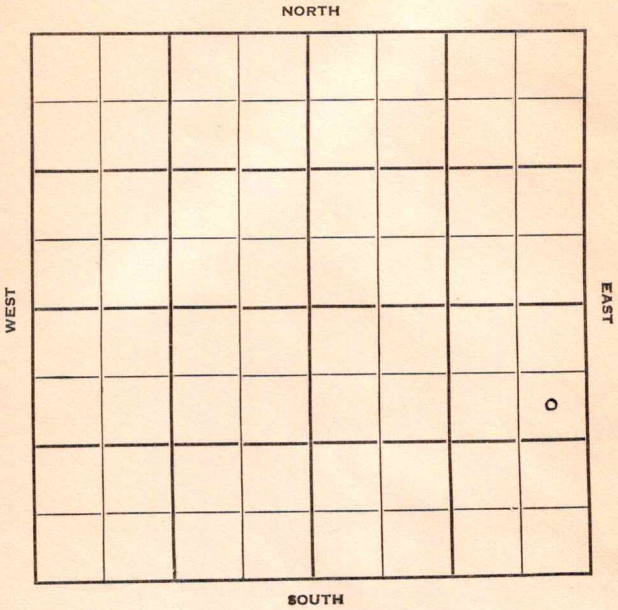

Ellis

KANSAS

Sec. 16 Twp. 13 R. 17W ✓

Well No. #4 F. A. Schmidt Farm

Texas Co. Company

Catherine Pool Contractor


990' Ft. from N. Line

_____ Ft. from S. Line

330' Ft. from E. Line

_____ Ft. from W. Line

SE NE SE

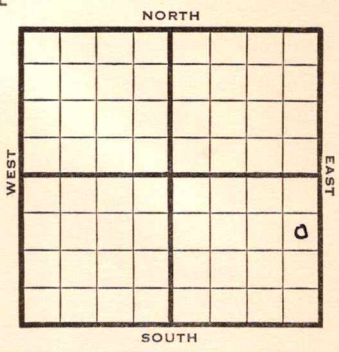

1950

Elev 1996

REPORT

6/28

Location

7/26

10" @ 1250

Heeb 3270

Lans 3320

Cong 3563

Arb 3593

TD 3623

D&A

ABANDONED

Map No. _____ Sec. 16 Twp. 13 R. 17W

Well No. 4 F. A. Schmidt

_____ Texas Co. _____ Company

_____ Contractor

SE NE SE

SECTION PLAT

990 Ft. from N. Line

_____ Ft. from S. Line

330 Ft. from E. Line

_____ Ft. from W. Line

FIRST REPORT

Ellis County

Location X

Rig up _____

Drilling and Remarks:

RECORD

Cased _____ in., _____ ft.

Sand _____

Gas _____

Oil _____

Total Depth _____

PRODUCTION

1st 24 hrs. Nat. _____

1st 24 hrs. after shot _____

Gas _____ Cu. Ft.

Dry Hole _____

Abandoned _____

Date

JUN 28 1950 19

J. E. TYRA Scout

Map No. _____ Sec. 16 Twp. 13 R. 17W

Well No. 4 F. A. Schmidt

_____ Texas _____ Company

_____ Contractor

SE NE SE

E1. 1996
SECTION PLAT

990 Ft. from N. Line

_____ Ft. from S. Line

330 Ft. from E. Line

_____ Ft. from W. Line

ABANDONED

o

Ellis County

Location _____

Rig up _____

Drilling and Remarks:

10" @ 1250

Heeb. 3272

Lans. 3320

Cong. 3563

Arb. 3593

TD 3623

D & A

RECORD

Cased _____ in., _____ ft.

Sand _____

Gas _____

Oil _____

Total Depth 3623

PRODUCTION

1st 24 hrs. Nat. _____

1st 24 hrs. after shot _____

Gas _____ Cu. Ft.

Dry Hole _____

Abandoned _____

Date

JUL 26 1950 19

J. E. TYRA Scout