


Russell
Kansas
Map No. _____ Sec. 8 Twp. 12 R. 15^W
Well No. 11 Oswald Farm
Valerious Company

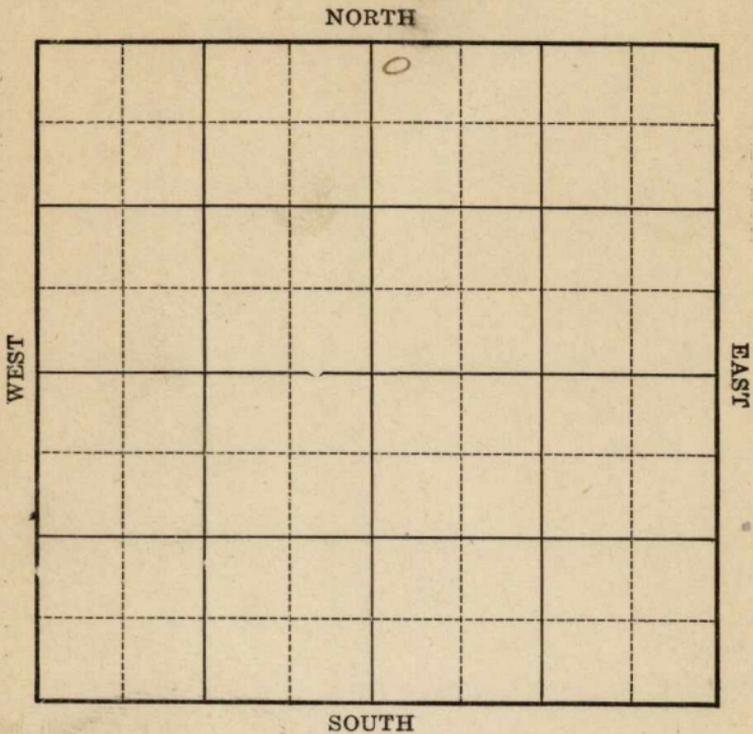

Location _____

Rig Up _____

Drilling Remarks _____

Drilling Remarks _____

RECORD

PRODUCTION

Cased _____ in. _____ ft.

Sand _____

Gas _____

Oil _____

Total Depth _____

1st 24 hrs. Nat. _____

1st 24 hrs. after shot _____

Gas _____ cu. ft.

Dry Hole _____

Abandoned _____

Map No. **KANSAS** Sec. 8 Twp. 12 R. 15W

Well No. 11 Oswald

Valerious Company

Contractor

SECTION PLAT

330 Ft. from N. Line

----- Ft. from S. Line

----- Ft. from E. Line

330 Ft. from W. Line

		0	

FIRST REPORT

Location -----

Rig up -----

Drilling and Remarks:

Location

RECORD

Cased ----- in., ----- ft.

Sand -----

Gas -----

Oil -----

Total Depth -----

PRODUCTION

1st 24 hrs. Nat. -----

1st 24 hrs. after shot -----

Gas ----- Cu. Ft.

Dry Hole -----

Abandoned -----

Date

OCT 6 1925
----- 192 -----

S. J. LEWIS Scout

home
Russell

Map No. **KANSAS** Sec. *8* Twp. *12* R. *10W*

Well No. *11 Oswalal*

Valerious Company

Contractor

SECTION PLAT

330 Ft. from N. Line

_____ Ft. from S. Line

_____ Ft. from E. Line

330 Ft. from W. Line

		<i>0</i>	

COMPLETED

Location _____

Rig up _____

Drilling and Remarks:

Sand 2935 to

2962

200 lbs 24 hrs

RECORD

Cased _____ in., _____ ft.

Sand _____

Gas _____

Oil _____

Total Depth _____

PRODUCTION

1st 24 hrs. Nat. _____

1st 24 hrs. after shot _____

Gas _____ Cu. Ft.

Dry Hole _____

Abandoned _____

Date

JAN 5 1926

S. J. LEWIS

Scout