


Section 22 Township 17 Range 13W

Well No. #1 Rexroot

Company B. & R. Drlg.

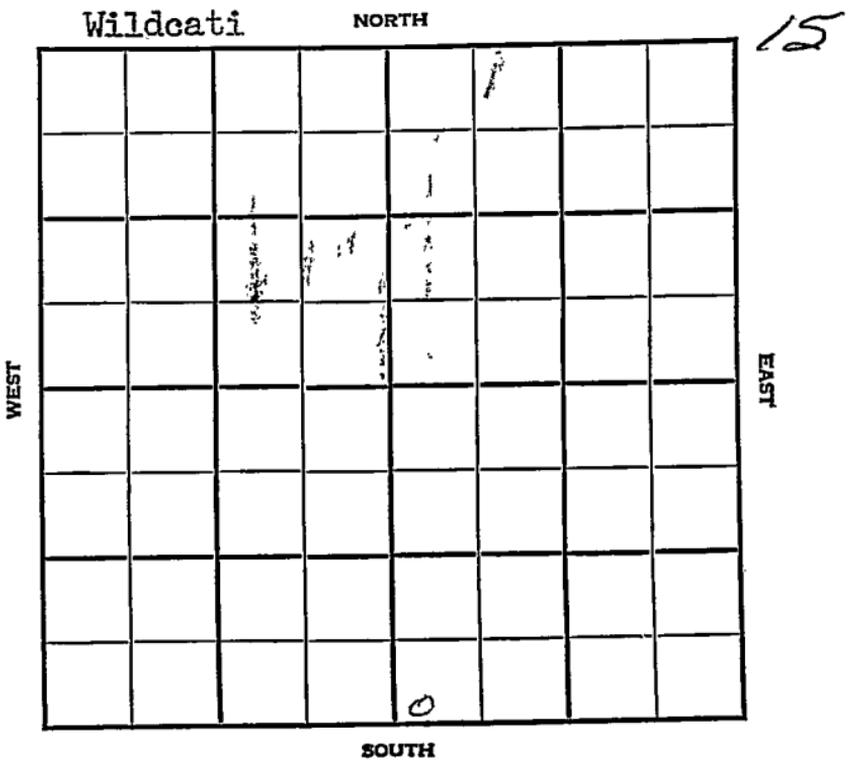

KANSAS

Sec. 22 Twp. 17 R. 13W

Well No. #1 Rexroot Farm _____
B&R Drlg. Company _____


Wildcat

_____ Ft. from N. Line

330 Ft. from S. Line

_____ Ft. from E. Line

330 Ft. from W. Line
SW SE

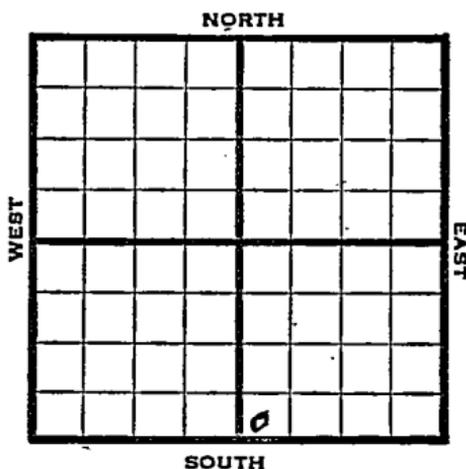

1947

Elev.

REPORT

10/22

8" @ 395'
2050'

10/29

Lansing 3135'
Arbuckle 3380
TD 3340'

ABANDONED

Kansas

Wildcat

Map No.

73

Sec. 22

Twp. 17

R. 13W

Well No.

1 Rexroot

B & R Drlg.

Company

FIRST REPORT

Contractor

SW SE


SECTION PLAT

_____ Ft. from N. Line

330 _____ Ft. from S. Line

_____ Ft. from E. Line

330 _____ Ft. from W. Line

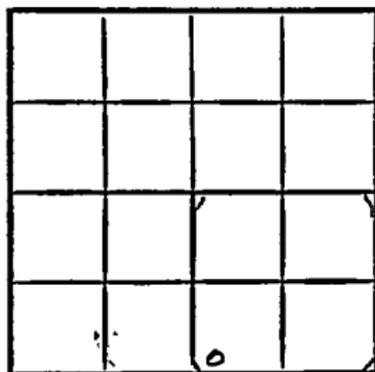

Barton County

Location _____

Rig up _____

Drilling and Remarks:

8" @ 395'

Anhy 810'

2050'

RECORD

Cased _____ in., _____ ft.

Sand _____

Gas _____

Oil _____

Total Depth _____

PRODUCTION

1st 24 hrs. Nat. _____

1st 24 hrs. after shot _____

Gas _____ Cu. Ft.

Dry Hole _____

Abandoned _____

Date

OCT 22 1947

19

S. J. LEWIS

Scout

