


Kenneth

Barton

Section 22 Township 17 Range 13W
Well No. #6 Boger
Company Derby et al
Hoisington Pool

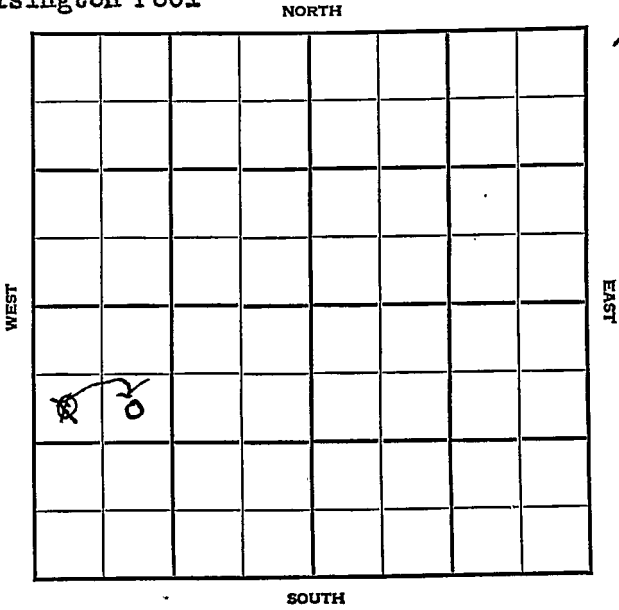

KANSAS

Barton

Sec. 22 Twp. 17 R. 13W

Well No. #6 Boger Farm

Derby et al Company

Hoisington Pool


990' Ft. from N. Line

 Ft. from S. Line

 Ft. from E. Line

990'
~~530'~~ Ft. from W. Line

SE NW SW

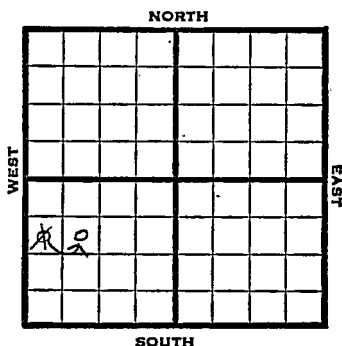

1948

Elev. 1929' REPORT

2/18 Location

2/25 8" @ 370'
WOC

3/3 Drlg. 2880'

3/10 Lansing 3180'
Arbuckle 3412'
TD 3415'
5" @ 3412'
RUST

3/17 "

3/24 500 Acid swb 30 bbls oil PH

3/31 Arbuckle 3412'
5" @ 3412'
500 Acid
Pump 100 Pot.
Gr. 36°
TD 3415'

COMPLETED

Map No. _____ Sec. 22 Twp. 17 R. 13W

Well No. 6 Boger

Derby et al. _____ Company

FIRST REPORT

Contractor

SE NW SW


990 Ft. from N. Line

_____ Ft. from S. Line

_____ Ft. from E. Line

330 Ft. from W. Line

SECTION PLAT

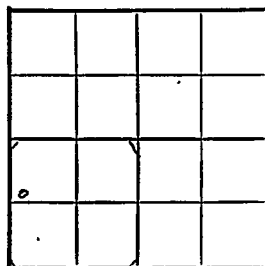

Barton County

Location X

Rig up _____

Drilling and Remarks:

RECORD

Cased _____ in., _____ ft.

Sand _____

Gas _____

Oil _____

Total Depth _____

PRODUCTION

1st 24 hrs. Nat. _____

1st 24 hrs. after shot _____

Gas _____ Cu. Ft.

Dry Hole _____

Abandoned _____

Date

FEB 18 1948

19

S. J. LEWIS

Scout

Map No. 73 Sec. 22 Twp. 17 R. 13WWell No. 6 BogerDerby etal. Company**CORRECTION** Contractor

SE NW SW

990 Ft. from N. Line Ft. from S. Line Ft. from E. Line990 Ft. from W. Line

SECTION PLAT

Barton CountyLocation Rig up

Drilling and Remarks:

Spotted

SW NW SW

RECORD

Cased in., ft.Sand Gas Oil Total Depth

PRODUCTION

1st 24 hrs. Nat. 1st 24 hrs. after shot Gas Cu. Ft.Dry Hole Abandoned

Date

FEB 1 8 1948 19S. J. LEWIS Scout

Map No. 73 Sec. 22 Twp. 17 R. 13W

Well No. 6 Boger

Derby etal. Company

COMPLETE Contractor

SE NW SW


5/1/928
SECTION PLAT

990 Ft. from N. Line

 Ft. from S. Line

 Ft. from E. Line

990 Ft. from W. Line

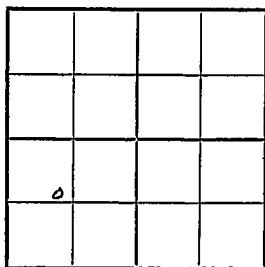

Barton County

Location

Rig up

Drilling and Remarks:

Cr 83412

5" 83412

500000

Pump 100 ft

36 2/3

RECORD

Cased in., ft.

Sand

Gas

Oil ✓

Total Depth 8415

PRODUCTION

1st 24 hrs. Nat.

1st 24 hrs. after shot

Gas Cu. Ft.

Dry Hole

Abandoned

Date

MAR 31 1948 19 S. J. LEWIS Scout