

KANSAS


Russell County

FORM 51 5M 6-46 PETROL

Section 8 Township 12 Range 15-W

Well No. #9, Oswald-Wilcox "A"

Company Sohio

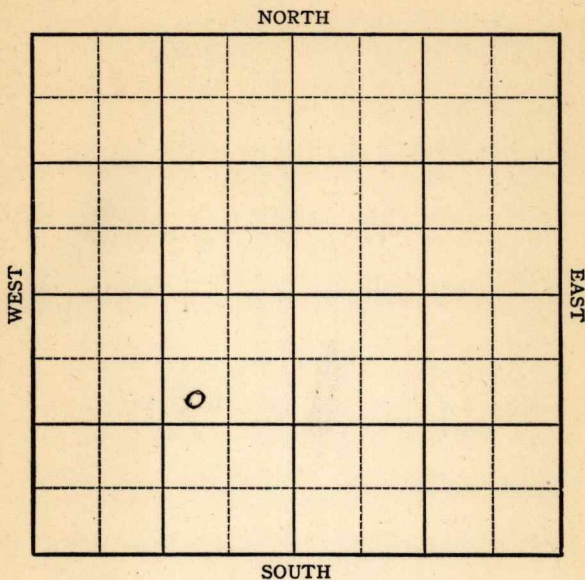

KANSAS

Russell County ✓

Sec. 8 Twp. 12 R. 15W

Well No. #9 Oswald-Wilcox^{"A"} (Twin to #1) Farm
Sohio Company


Fairport

990 Ft. from N. Line

Ft. from S. Line

990 Ft. from E. Line

Ft. from W. Line

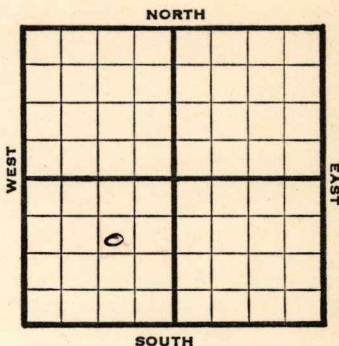

SW NE SW

1946

1844

REPORT

9/25 Location

10/1 Surf

10/8 "

10/15 10" @ 650'

Drlg 1545'

10/22 Drlg 2787'

10/29 Arb 3236-38 TD
5" @ 3263, RUST11/6 Arb 3228', Corrected
5" @ 3228'
TD 3236'
3500 acid11/13 Arb 3228'
5" @ 3228'
TD 3236'
3500 Acid
Pump 200 POT
39 Grav.

COMPLETED

KANSASKansas Pool Name FairportMap No. 72 Sec. 8 Twp. 12 R. 15WWell No. 9 Oswald-Wilcox "A"Sohio

Company

FIRST REPORT

Contractor

SW NE SW

SECTION PLAT990 Ft. from N. Line Ft. from S. Line990 Ft. from E. Line Ft. from W. Line

Russell County**RECORD**Location XCased in., ft.Rig up Sand

Drilling and Remarks:

Gas

Twin to # 1

Oil Total Depth **PRODUCTION**1st 24 hrs. Nat. 1st 24 hrs. after shot Gas Cu. Ft.Dry Hole Abandoned

Date

SEP 25 194619S. J. LEWISScout

Kansas

Map No. 72 Sec. 8 Twp. 12 R. 15WWell No. 9 Oswald-Wilcox "A"

Sohio

Company

COMPLETED

Contractor

SW NE SW

E. 1844
SECTION PLAT990 Ft. from N. Line Ft. from S. Line990 Ft. from E. Line Ft. from W. Line

Russell County

RECORD

Location Rig up

Drilling and Remarks:

Cased in., ft.Sand Gas Oil Total Depth 9286

PRODUCTION

1st 24 hrs. Nat. 1st 24 hrs. after shot Gas Cu. Ft.Dry Hole Abandoned

Date

NOV 13 1946 19

S. J. LEWIS

Scout