


DX 78-1

Barton

Section 23 Township 17 Range 13W

Well No. #1 Elmore

Company Duke Drlg.

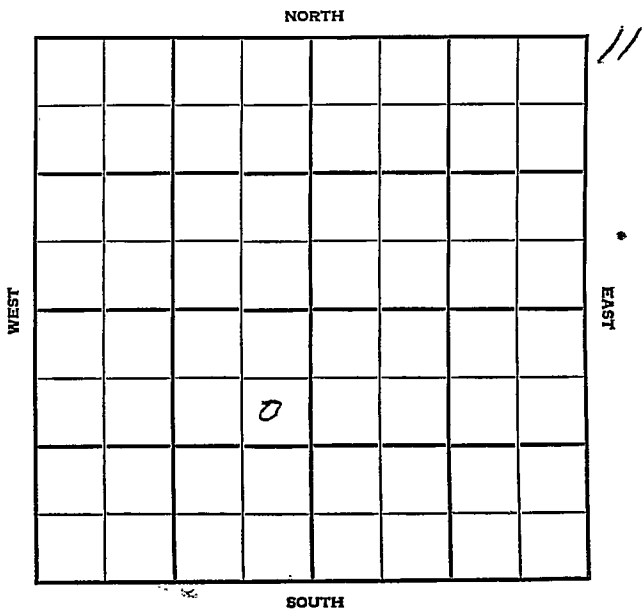

County Barton Elev. _____
 Sec. 23 Twp. 17 Rge. 13W
 Company Duke Drig.
 Farm Name Elmore No. 1

TOPS	DEPTH	LOG	DATUM
Anh.			
Tr.			
H.			
Tr.			
Dg.			
Bl.			
L.			
K.C.			
B.K.C.			
Ce.			
C.			
M.			
M.			
K.			
Mz.			
Mo.			
V.			
S.			
S.			
A			
R.			
PE.			
G.			
T.D.			

Loc. in Sec. _____
NE SE SW
 Geol. _____
 Contr. _____
 Co. tools _____
 Pool _____
E. Hoisington

FIRST REPORT
 JUN 15 '55

Date Comm. 6-10-55
8" @ 331/175 drlg. 1826

Co.
Lse.
No.
Sec.
T.
R.

County Barton Elev. _____
 Sec. 23 Twp. 17 Rge. 13W
 Company Duke Drlg.
 FarmName Elmore No. 1

TOPS	DEPTH	LOG	DATUM	Loc. in Sec.
Anh.				NE SE SW
Tr.				
H.	<u>3014</u>		<u>1159</u>	
Tr.				
Dg. <u>sh</u>	<u>3042</u>		<u>1187</u>	
Bl.	<u>3161</u>		<u>1246</u>	
L.	<u>3114</u>		<u>1259</u>	Geol. _____
K.C.				Contr. _____
B.K.C.				Co.'s tools _____
Ce.				Pool _____
C.	<u>32</u>			E. Hoisington
M.				
M.				
K.				
Mz.				
Me.				
V.				
S.				
S.				
A.	<u>3357</u>		<u>1502</u>	COMPLETE
R.				
PE.				
G.				
T.D.	<u>3361</u>			

Date Comm. 6-10-55 AUG 1 0 1955
 8" @ 331/175 DST 3116-54 open 1 hr.
 Rec. 7' mud Off DST 3152-85 open 1hr.
 Rec. 52' hocm. 95# DST 3152-84
 open 1 hr. Rec. 12' ocm Off
 DST 3354-61 open 1 hr. Rec. 120' muddy
 oil 15' muddy wtr. 925/20" 5 1/2" @
 3358 CO to 3361 500 A S/ 6 bo 4 hr.
 Comp. 107 bopd