

Ellis

Section 17 Township 13 Range 17-W

Well No. #2 Miller


Company Derby 'etal.

(Sugar Loaf)

NORTH

WEST

EAST

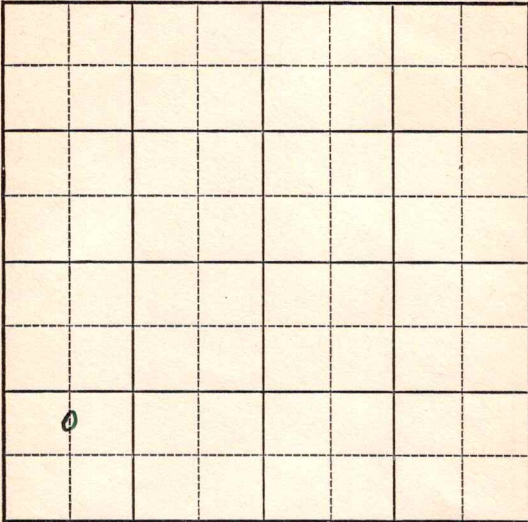

SOUTH




Ellis

KANSAS

Map No. 71 Sec. 17 Twp. 13 R. 17WWell No. 2 MillerDerby et al. CompanyFIRST REPORT Contractor

C NL SW SW

## SECTION PLAT

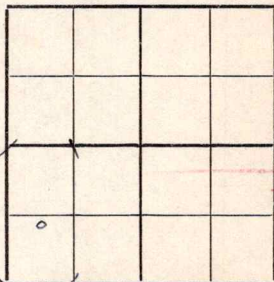         Ft. from N. Line990 Ft. from S. Line         Ft. from E. Line660 Ft. from W. Line

SUGAR LOAF POOL

Location                                 Rig up                                 

Drilling and Remarks:

Rotary

## RECORD

Cased                  in.,                  ft.Sand                                 Gas                                 Oil                                 Total Depth                                 

## PRODUCTION

1st 24 hrs. Nat.                                 1st 24 hrs. after shot                                 Gas                                  Cu. Ft.Dry Hole                                 Abandoned                                 

Date

DEC 10 1941 19S. J. LEWIS Scout

Map No. 71 Sec. 17 Twp. 13 R. 17WWell No. 2 MillerDerby etal. CompanyABANDONED Contractor

C NL SW SW

## SECTION PLAT

|  |  |  |  |
|--|--|--|--|
|  |  |  |  |
|  |  |  |  |
|  |  |  |  |
|  |  |  |  |

       Ft. from N. Line990 Ft. from S. Line       Ft. from E. Line660 Ft. from W. LineSUGAR LOAF POOL

## RECORD

Location                                 Cased            in.,            ft.Rig up                                 Sand                                 

Drilling and Remarks:

Gas                                 Cong 3676Oil                                 3704 in Cong.Total Depth 3704

## PRODUCTION

1st 24 hrs. Nat.                                 1st 24 hrs. after shot                                 Gas                                  Cu. Ft.Dry Hole                                 Abandoned                                 

Date

DEC 30 194119S. J. LEWIS Scout