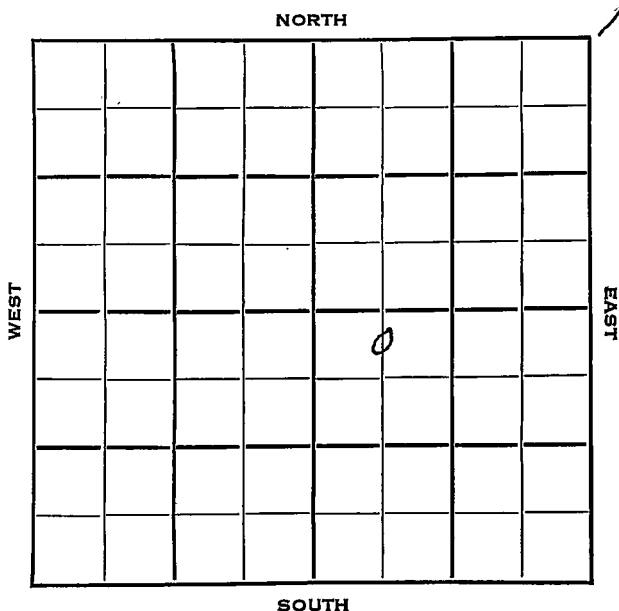


Barton

KANSAS

Section 23- Township 17 Range 13WWell No. #1 MunnsCompany E.K. Carey

Barton KANSAS

SEC.	TWP.	R.
23	17	13W ✓

WELL NO.

1 Munns

FARM

COMPANY

E. K. Carey

CONTRACTOR

Carey Drlg.

Wildcat


330 Ft. from N. Line

Ft. from S. Line

Ft. from E. Line

660 Ft. from W. Line

C N L NW SE

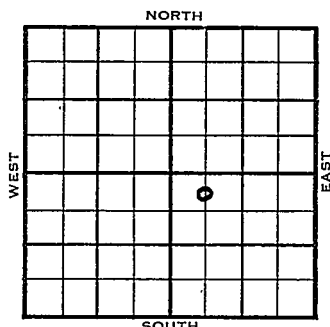

1954

ELEVATION
1840'

REPORT

3/10

Spud 3-2-54
8" @ 305'
Drlg. 2404'

3/17

Heeb 2992', Br li 3078', Lans 3092'
DST 3106-66', 3/4 hrs., 2430' clean
oil, 1040#
DST 3165-74', 1 hr., 1240' gas, 160'
MCO, 60' SW, 1090#
Cong 3336', Arb. 3338'
RTD 3343'
5" @ 3340'

3/24

WOCT

3/31

CO 3343' FU 700' oil S/19 BOPH
3 hrs. POP

4/7

NR

4/14

Spud 3-2-54
Oil Well
TD 3343'
8" @ 305'

Heeb 2992', Br. Lime 3078', Lans 3092'
DST 3106'-66' opn 3/4 hr, rec 2430'
clean oil 1040#

DST 3165'-74' opn 1 hr, rec 1240' gas
160' mco 60' sw 1090# cong 3338'

OVER

1954

Information brought forward.

4/14

Arb 3338',


TD 3343'

5" @ 3340'

CO to 3343' FU 700' oil S/ 19 boph 3
hr.

Comp 240 bopd 5% Wtr.

COMPLETED

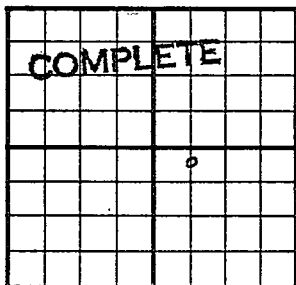County Barton State KANSASSec. 23 (Blk.
Twp.) 17 (Sur.
Rge.) 13W Map No.Operator E. K. CareyWell No. 1 Farm MunnsElev. 1840 Location C N L NW SE330 Ft. From N Line SE660 Ft. From W Line Quarter

1st. Report

Completion APR 14 1954Remarks WildcatCarey Drlg. - Contr.Spudding Date 3-2-54Drlg. Data Oil well TD 33438" @ 305 Heeb. 2992 Br. lime 3078Lans. 3092 DST 3106-66 open 3/4 hr.Rec. 2430' clean oil 1040# DST 3165-74open 1 hr. Rec. 1240' gas 160' mco60' sw 1090# Cong. 3336 Arb. 3338TD 3343 5" @ 3340 CO to 3343 FU 700'oil S/ 19 boph 3 hr., Comp. 240 bopd5% wtr.

J. G. McGEHEE