


Section 22 Township 17 Range 13W

Well No. #2 Stoskopf

Company Nadel & Gussman

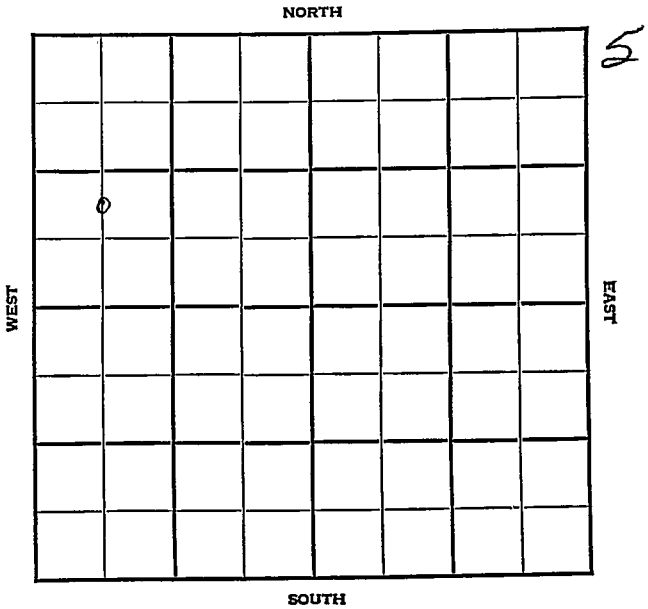

KANSAS

Barton

Sec. 22 Twp. 17 R. 13-W

Well No. #2 Stoskopf Farm

Nadel & Gussman Company

Hoisington Pool


 Ft. from N. Line

990' Ft. from S. Line

 Ft. from E. Line

660' Ft. from W. Line

C N L SW NW

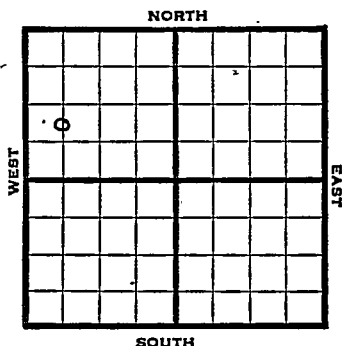

1947

Elev. 1940' REPORT

11/25

Location

12/3

Lansing 3183'
Arbuckle 3406'
TD 3408'
5" @ 3407'
RUST

12/10

TD 3410'

12/23

Arb. 3406'
5" @ 3407'
500 acid
Pump 300 Pot
Gr. 37.0
TD 3414'

COMPLETED

Map No. _____ Sec. 22 Twp. 17 R. 13W

Well No. 2 Stoskopf

Nadel & Gussman Company

FIRST REPORT Contractor

C N L SW NW


SECTION PLAT

_____ Ft. from N. Line

990 Ft. from S. Line

_____ Ft. from E. Line

660 Ft. from W. Line

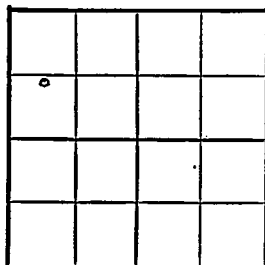

Barton County

Location X

Rig up _____

Drilling and Remarks:

RECORD

Cased _____ in., _____ ft.

Sand _____

Gas _____

Oil _____

Total Depth _____

PRODUCTION

1st 24 hrs. Nat. _____

1st 24 hrs. after shot _____

Gas _____ Cu. Ft.

Dry Hole _____

Abandoned _____

Date

NOV 25 1947

19

S. J. LEWIS Scout

Map No. 73 Sec. 22 Twp. 17 R. 13W

Well No. 2 Stoskopf

Nadel & Gussman Company

COMPLETE

Contractor

C N L SW NW

E11940


SECTION PLAT

 Ft. from N. Line

990 Ft. from S. Line

 Ft. from E. Line

660 Ft. from W. Line

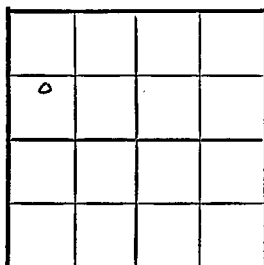

Barton County

Location

Rig up

Drilling and Remarks:

*Per 3406
5" @ 3407.
500 acid
Pump 300 ft*

27 2/3

RECORD

Cased in., ft.

Sand

Gas

Oil

Total Depth 3414

PRODUCTION

1st 24 hrs. Nat.

1st 24 hrs. after shot

Gas Cu. Ft.

Dry Hole

Abandoned

Date

DEC 23 1947

19

S. J. LEWIS

Scout