

KANSAS


Section 22 Township 17 Range 13N

Well No. #3 Steskopf

Company Nadel & Gussman

Hoisington Pool

NORTH

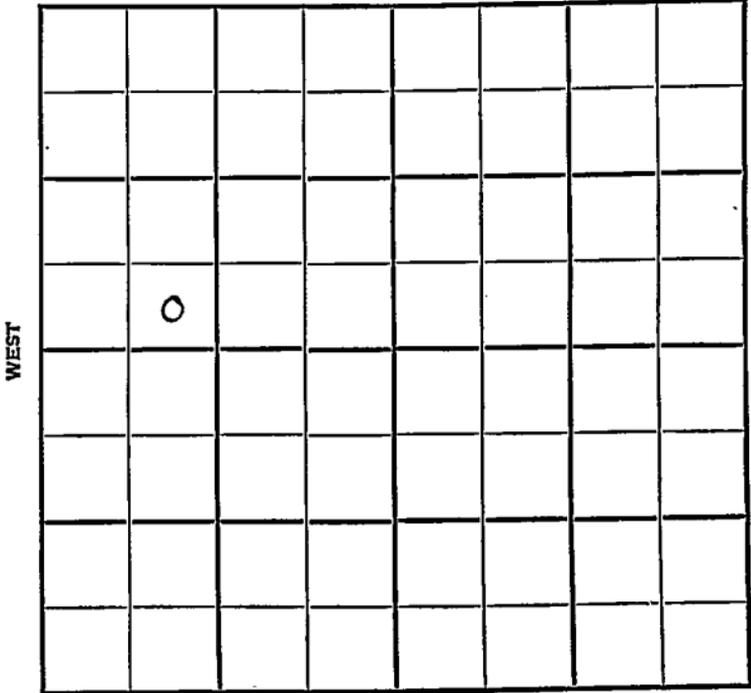

5

WEST

EAST

SOUTH

KANSAS

Barton



Sec. 22 Twp. 17 R. 13W

Well No. #3 Stoskopf Farm
Nadel & Gussman Company

Hoisington Pool


_____ Ft. from N. Line

330' _____ Ft. from S. Line

_____ Ft. from E. Line

990' _____ Ft. from W. Line

SE SW NW

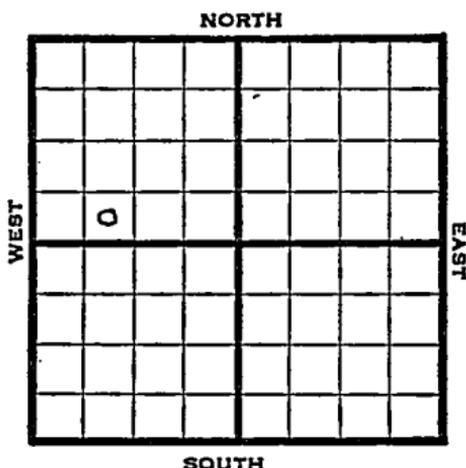

1948 Elev. 1926' REPORT

- 2/11 8" @ 210'
WOC
- 2/18 Drlg 2560'
- 2/25 Arbuckle 3406'
TD 3407'
5" @ 3406'
RUST
- 3/3 TD 3420'
Swb $\frac{1}{2}$ bbl oil, PH
- 3/10 "
- 3/17 1000 acid.
- 3/24 Arbuckle 3406'
5" @ 3406'
1000 Acid
Pump 20 Pot.
Gr. 36°
TD 3420'

COMPLETED

Map No. _____ Sec. 22 Twp. 17 R. 13W

Well No. 3 Stoskopf

Nadel & Gussman Company

FIRST REPORT Contractor

SE SW NW

SECTION PLAT

_____ Ft. from N. Line

330 Ft. from S. Line

_____ Ft. from E. Line

990 Ft. from W. Line

Barton County

Location _____

Rig up _____

Drilling and Remarks:

8" @ 210 WOC

RECORD

Cased _____ in., _____ ft.

Sand _____

Gas _____

Oil _____

Total Depth _____

PRODUCTION

1st 24 hrs. Nat. _____

1st 24 hrs. after shot _____

Gas _____ Cu. Ft.

Dry Hole _____

Abandoned _____

Date

FEB 1 1 1948 19

S. J. LEWIS Scott

