


Russell

Map No. Kansas Sec. 8 Twp. 12 R. 15^w

Well No. 13 Oswald Farm _____
Valerious Company _____

NORTH

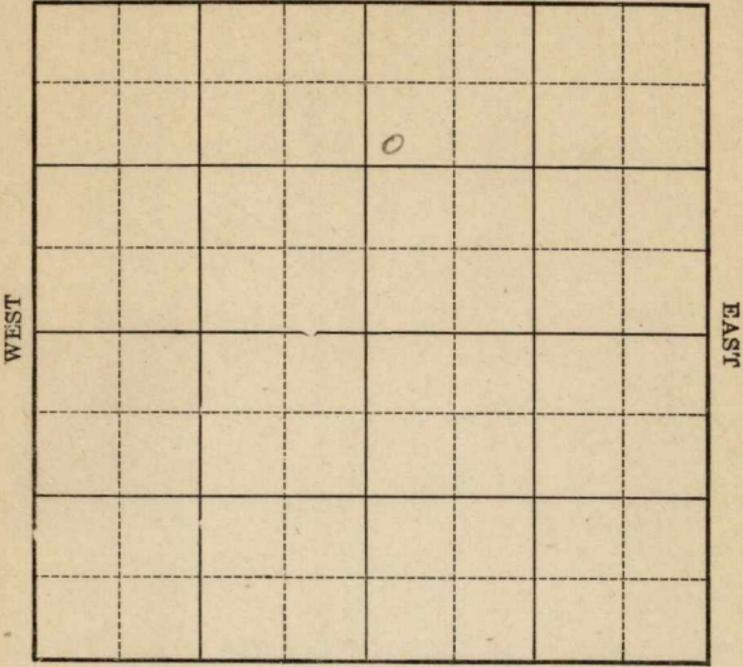

SOUTH

Location _____

Rig Up _____

Drilling Remarks _____

Drilling Remarks _____

RECORD

PRODUCTION

Cased _____ in. _____ ft.

Sand _____

Gas _____

Oil _____

Total Depth _____

1st 24 hrs. Nat. _____

1st 24 hrs. after shot _____

Gas _____ cu. ft.

Dry Hole _____

Abandoned _____

Map No. Russell Kansas Sec. 8 Twp. 12 R 15^w


Well No. 13 Oswald Farm
Valerious Company

990 Ft. from N. Line

..... Ft. from S. Line

..... Ft. from E. Line

300 Ft. from W. Line

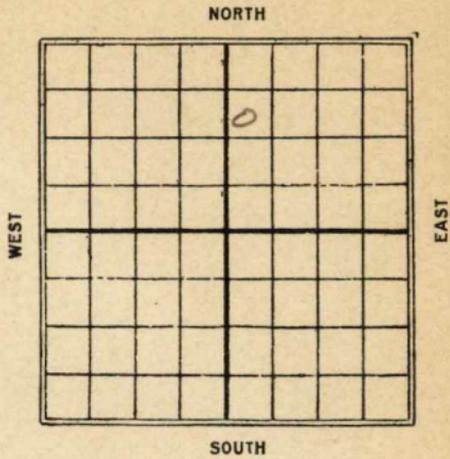

Date

REPORT

1925

12/16 R.O.G.

1926

3/9 Sand 2912-62 120 bbls

Map No. *KANSAS* Sec. *8* Twp. *12* R. *15W*

Well No. *13 Oswald*

Valerious et al Company

Contractor

SECTION PLAT

		0	

990 Ft. from N. Line

_____ Ft. from S. Line

_____ Ft. from E. Line

300 Ft. from W. Line

COMPLETED

Location _____

Rig up _____

Drilling and Remarks:

Sand 2912 to

2962.

120 lbs.

RECORD

Cased _____ in., _____ ft.

Sand _____

Gas _____

Oil _____

Total Depth _____

PRODUCTION

1st 24 hrs. Nat. _____

1st 24 hrs. after shot _____

Gas _____ Cu. Ft.

Dry Hole _____

Abandoned _____

Date

MAR 9 1926

S. J. LEWIS

Scout

Map No. KANSAS Sec. 8 Twp. 12 R. 15W

Well No. 13 Oswald

Valerious Company

Contractor

SECTION PLAT

		0	

990 Ft. from N. Line

----- Ft. from S. Line

----- Ft. from E. Line

900 Ft. from W. Line

FIRST REPORTS

Location -----

Rig up -----

Drilling and Remarks:

ROG

RECORD

Cased ----- in., ----- ft.

Sand -----

Gas -----

Oil -----

Total Depth -----

PRODUCTION

1st 24 hrs. Nat. -----

1st 24 hrs. after shot -----

Gas ----- Cu. Ft.

Dry Hole -----

Abandoned -----

Date

DEC 16 1925

S. J. LEWIS Scout