

Sec. 17 Twp. Ellis 13 R. 17W

Well No. #3 Miller Farm

Derby Oil et al Company

Peel Drlg. Contractor

Sugar Loaf Pool


 Ft. from N. Line

990' Ft. from S. Line

 Ft. from E. Line

330' Ft. from W. Line

NW SW SW

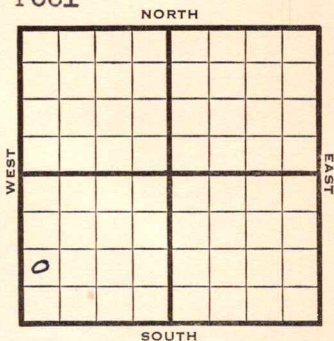

1950

Elev. 2131' REPORT

7/5

Pits

10/4

8 5/8" @ 275

KC 3440

DST 3445-90 rec 120' ocm

DST 3494-3511 opn 50 min rec 400' ocm & SW

Heeb 3362

Lans 3432

B K/8 3650

Cong 3663

TD 3666

4 1/2" 3536

13/3499-3500 rec 200' sw

PB 3495

24/3486-95 5 bsw 1 hr

PB 3478

12/3464-70 3 bo 5 bwph

SP 3460

8/3456-58 5 go 5 gswph

SP 3441

CO to 3497

9/3495-96

24/3486-92 1000 g S/5 boph 3 go

PB 3480

15/3464-70 7 gwph 8/3456-58 35 go

15 gwph 1000 A SP 3450

8/3455-47 900' sw SP 3442

16/3432-39, S/46 bsw 3 hr SP 3424

Sq off 3432-47

CO 3476 S/3 bo 1/2 bwph Comp 39 bopd

Completed

COMPLETED

Map No. _____ Sec. 17 Twp. 13 R. 17W

Well No. 3 Miller

_____ Derby Oil etal. _____ Company

_____ Contractor

NW SW SW

E1. 2131
SECTION PLAT

_____ Ft. from N. Line

990 Ft. from S. Line

_____ Ft. from E. Line

330 Ft. from W. Line

FIRST REPORT

Ellis County

Location _____

Rig up _____

Drilling and Remarks:

Pits

RECORD

Cased _____ in., _____ ft.

Sand _____

Gas _____

Oil _____

Total Depth _____

PRODUCTION

1st 24 hrs. Nat. _____

1st 24 hrs. after shot _____

Gas _____ Cu. Ft.

Dry Hole _____

Abandoned _____

Date

JUL 5 1950 19

J. E. TYRA Scout

