

Barton


FORM 51

KANSAS

Section 23 Township 17 Range 13W

Well No. #1 Munns "B" "A"

Company E.K. Carey

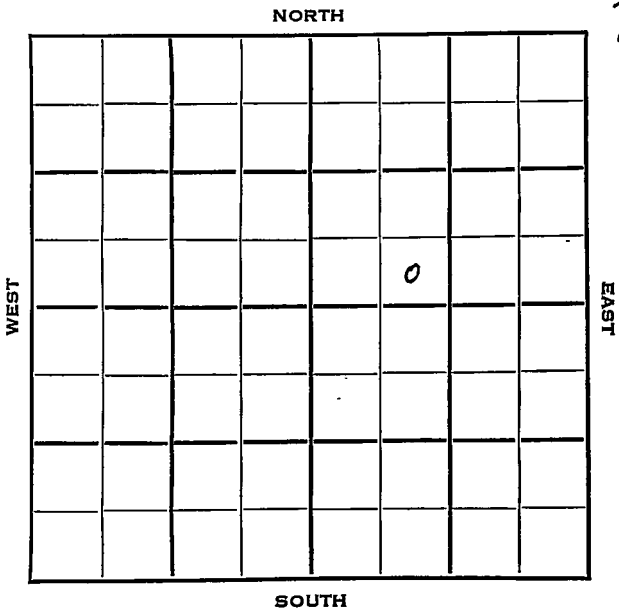

Barton

KANSAS

SEC.	TWP.	R.
23	17	13W ✓

WELL NO.

#1 Munns ^{"A"}~~"B"~~

FARM

COMPANY

E.K. Carey

CONTRACTOR

Carey


_____ Ft. from N. Line

330 _____ Ft. from S. Line

_____ Ft. from E. Line

990 _____ Ft. from W. Line

SE SW NE

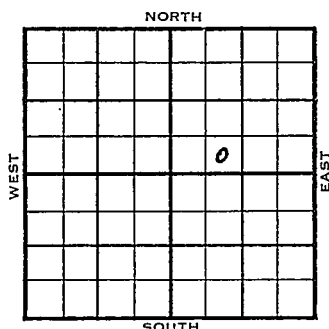

	ELEVATION	REPORT
1954	1841'	

3/31
4/7RUR
8" @ 376'
rlg. 2181'

6/9

Spud 4-1-54 Oil well TD 3344'
 8" @ 376' Lans. 3093'
 DST 3085-3145 open 1 hr 15 min,
 red 90' MCO 400' gas 515#
 DST 3145-65, open 1 hr rec 10' mud.
 30# Arb. 3337'
 DST 3327-44 open 1 hr rec 165' muddy
 oil 900# TD 3344' 5" @ 3340
 CO to 3344 2 BFPH 20% wtr. 250 A
 FU 2145' fluid 15 hr. ~~8/15~~
 S/5½ BO 7 BWPB 4 hr.
 Comp. 20 BOPD 75% wtr.

COMPLETED

County Barton State Kansas

Sec. 23 (Blk. Twp.) 17 (Sur. Rge.) 13W Map No.

Operator E. K. Carey

Well No. 1 Farm Munns "B"

Elev. _____ Location **SE SW NE**

FIRST REPORT

330 Ft. From S Line NE

990 Ft. From W Line Quarter

1st. Report MAR 31 1954

Completion: _____

Remarks

Carey - Contr.

Spudding Date _____

Drlg. Data

R U R

DANES

Map No. _____ Sec. 23 Twp. 17 R. 13WWell No. 1 Munns "A"E. K. Carey Company**CORRECTION**

Contractor

SE SWNE

SECTION PLAT

_____ Ft. from N. Line

330 Ft. from S. Line

_____ Ft. from E. Line

990 Ft. from W. Line

		c	

Barton County

Location _____

Rig up _____

Drilling and Remarks:

Reported

#1 Munns "B"

RECORD

Cased _____ in., _____ ft.

Sand _____

Gas _____

Oil _____

Total Depth _____

PRODUCTION

1st 24 hrs. Nat. _____

1st 24 hrs. after shot _____

Gas _____ Cu. Ft.


Dry Hole _____

Abandoned _____

Date

APR 28 1954 19J. G. McGEHEE

Scout

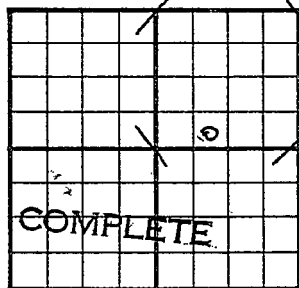County Barton State KansasSec. 23 (Blk.
Twp.) 17 (Sur.
Rge.) 13W Map No.Operator E. K. CareyWell No. 1 Farm Munns "A"Elev. 1841 Location SE SW NE330 Ft. From S Line NE990 Ft. From W Line Quarter

1st. Report

Completion JUN 9 1954

Remarks

Carey Drlg. - Contr.Spudding Date 4-1-54Drlg. Data Oil well TD 33448" @ 376 Lans. 3093 DST 3085-3145open 1 hr. 15 min. Rec. 90' mco400' gas 515# DST 3145-65 open 1 hr.Rec. 10' mud 30# Arb. 3337 DST 3327-44open 1 hr. Rec. 165' muddy oil 900#TD3344 5" @ 3340 CO to 3344 2 bfph20% wtr. 250 A FU 2145' fluid 15 hr.S/ 5 $\frac{1}{2}$ bo 7 bwph 4 hr.Comp. 20 bopd 75% wtr.