

Section 24 Township 17 Range 13W

Well No. #1 Gzermack "A"

Company C R A & Northern American Prod.

NORTH

2

				0			

WEST

EAST

SOUTH

Barton

KANSAS

Sec. 24 Twp. 17 R. 13W

Well No. #1 Czermack "A" Farm

C R A & Northern American Prod. Company

Contractor

Wildcat


330' Ft. from N. Line

_____ Ft. from S. Line

_____ Ft. from E. Line

330' Ft. from W. Line

NW NW NE

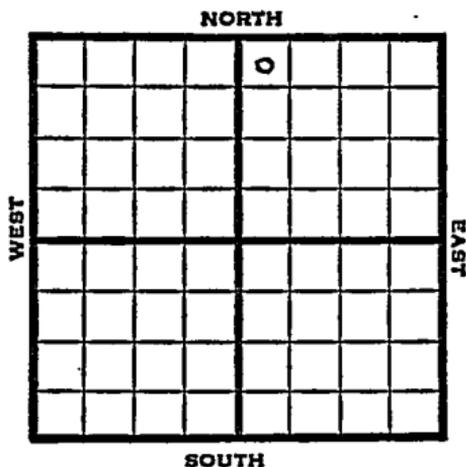

1951

Elev. 1840' REPORT

3/21

Location

4/4
 Spud 3-22-51 D & A TD 3386'
 8" @ 251 Heeb 3002' Toronto 3020'
 Br. line 3093' Lans. 3112'
 Cong 3344' Arb. 3357-86 TD
 D & A

ABANDONED

County Barton State Kansas

Sec. 24 (Blk. Twp.) 17 (Sur. Rge.) 13W Map No.

Operator C R A & Northern American Prod.

Well No. 1 Farm Czermack "A"

Elev. _____ Location NW NW NE

330 Ft. From N Line NE

330 Ft. From W Line Quarter

Ist. Report MAR 21 1951

Completion _____

Remarks Stan. & Globe DHM

Spudding Date _____

Drilg. Data Wildcat

Location

County Barton State Kansas

Sec. 24 (^{Blk.}_{Twp.}) 17 (^{Sur.}_{Rge.}) 13W Map No.

Operator C R A & North American Prod.

Well No. 1 Farm CZermack "A"

Elev. 1840 Location NW NW NE

~~ABANDONED~~

330 Ft. From N Line NE

330 Ft. From W Line Quarter

Ist. Report

Completion APR 4 1951

Remarks Wildcat

Spudding Date 3-22-51

Drlg. Data D & A TD 3386

8" @ 251 Heeb. 3002 Toronto 3020

Br. lime 3093 Lans. 3112 Cong. 3344

Arb. 3357-86 TD D & A