

KANSAS

Ellis


FORM 51 IOM 12-46 PETROL

Section 17 Township 13 Range 17W

Well No. #1 Staab

Company Texas

Catherine • NORTH

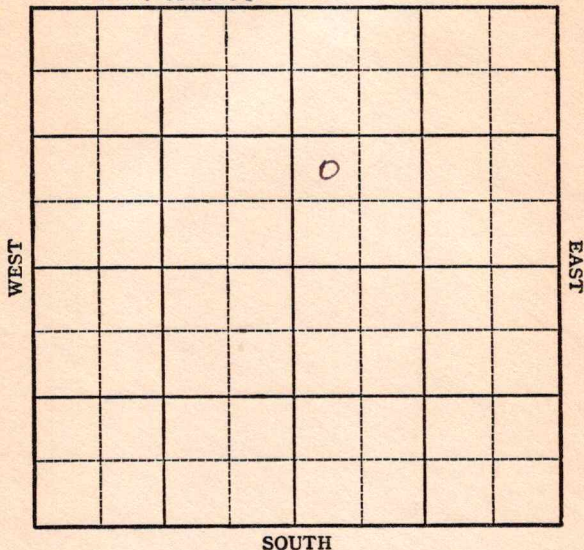

KANSAS

Ellis

Sec. 17 Twp. 13 R. 17-WWell No. 1 Staab FarmTexas

Company

Catherine Pool

Ft. from N. Line

990


Ft. from S. Line

Ft. from E. Line

330

Ft. from W. Line

NW SW NE

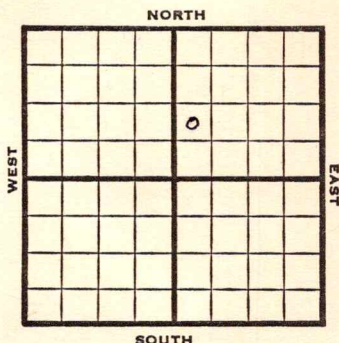

1947

Elev. 2045

REPORT

9/3 Loc.

9/10 RUR

9/17 10" @ 1311'
Drilg. 2325'9/24 **Lansing 3348'**
Conglomerate 3363'
TD 3367'10/1 Perf 3892
TD 3932**ABANDONED**

Map No. _____ Sec. 17 Twp. 13 R. 17W

Well No. 1 Staab

Texas

Company

FIRST REPORT

Contractor

NW SW NE

SECTION PLAT

		0	

_____ Ft. from N. Line

990 Ft. from S. Line

_____ Ft. from E. Line

330 Ft. from W. Line

Ellis County

Location X

Rig up _____

Drilling and Remarks:

RECORD

Cased _____ in., _____ ft.

Sand _____

Gas _____

Oil _____

Total Depth _____

PRODUCTION

1st 24 hrs. Nat. _____

1st 24 hrs. after shot _____

Gas _____ Cu. Ft.

Dry Hole _____

Abandoned _____

Date

SEP 3 1947 19

S. J. LEWIS Scout

Map No. 71 Sec. 17 Twp. 13 R. 17W

Well No. 1 Staab

Texas

Company

ABANDONED

Contractor

NW SW NE

E 1, 20 45

SECTION PLAT

		6	

 Ft. from N. Line

990 Ft. from S. Line

 Ft. from E. Line

330 Ft. from W. Line

Ellis County

Location

Rig up

Drilling and Remarks:

Act 3892

RECORD

Cased in., ft.

Sand

Gas

Oil

Total Depth 892

PRODUCTION

1st 24 hrs. Nat.

1st 24 hrs. after shot

Gas Cu. Ft.

Dry Hole

Abandoned

Date

OCT 1 1947 19

S. J. LEWIS Scout