

15-063-20301


KANSAS DRILLERS LOG

WICHITA BRANCH

API No. 15 — 063 — 20,301-A
County Number

Operator T & D Oil Company	
Address Box 278 Victoria, Kansas 67671	
Well No. #2	Lease Name Munsell
Footage Location 996.0 feet from (N) (S) line 330 feet from (E) (W) line	
Principal Contractor Lawhanco	Geologist
Spud Date 7-29-78	Total Depth 4190
Date Completed	P.B.T.D. 1737
Oil Purchaser	

S. 13 T. 15 R. 28 NE
Loc. NE SW NE
County Gove

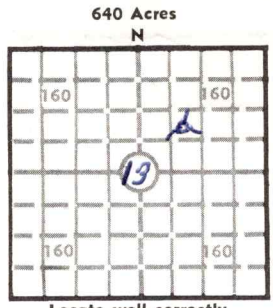

Locate well correctly
Elev.: Gr. 2434
DF 2436 KB 2439

CASING RECORD

Report of all strings set — surface, intermediate, production, etc.

Purpose of string	Size hole drilled	Size casing set (in O.D.)	Weight lbs/ft.	Setting depth	Type cement	Sacks	Type and percent additives
Surface	12 1/4	8 5/8	28	250			
Disposal	7 7/8	4 1/2	9 1/2	1780	Common&posmix	500	50/50

LINER RECORD

PERFORATION RECORD

Top, ft.	Bottom, ft.	Sacks cement	Shots per ft.	Size & type	Depth interval
			One	Strip Jet	1590-1620
TUBING RECORD					
Size	Setting depth	Packer set at			
2 3/8"	1302	1304			

ACID, FRACTURE, SHOT, CEMENT SQUEEZE RECORD

Amount and kind of material used	Depth interval treated

INITIAL PRODUCTION

Date of first production SWD		Producing method (flowing, pumping, gas lift, etc.)			
RATE OF PRODUCTION PER 24 HOURS	Oil bbls.	Gas MCF	Water bbls.	Gas-oil ratio	CFPB
Disposition of gas (vented, used on lease or sold)			Producing interval (s)		

INSTRUCTIONS: As provided in KCC Rule 82-2-125, within 90 days after completion of a well, one completed copy of this Drillers Log shall be trans-
mitted to the State Geological Survey of Kansas, 4150 Monroe Street, Wichita, Kansas 67209. Copies of this form are available from the Conservation
Division, State Corporation Commission, 3830 So. Meridian (P.O. Box 17027), Wichita, Kansas 66217. Phone AC 316-522-2206. If confidential custody
is desired, please note Rule 82-2-125. Drillers Logs will be on open file in the Oil and Gas Division, State Geological Survey of Kansas, Lawrence, Kansas
66044.

Operator T&D Oil Company		DESIGNATE TYPE OF COMP.: OIL, GAS, DRY HOLE, SWDW, ETC.: SWDW	
Well No. Two	Lease Name Munsell		
S 13 T 15 R 28 E W			
WELL LOG Show all important zones of porosity and contents thereof; cored intervals, and all drill-stem tests, including depth interval tested, cushion used, time tool open, flowing and shut-in pressures, and recoveries.		SHOW GEOLOGICAL MARKERS, LOGS RUN, OR OTHER DESCRIPTIVE INFORMATION.	
FORMATION DESCRIPTION, CONTENTS, ETC.	TOP	BOTTOM	NAME DEPTH
Washed hole down to old T.D. (4190). DST#1 (Straddle) Recovered; 20' Mud Pressure; IFP 68-123 ISIP 396 FFP not taken FSIP not taken	3996	4068	
DST#2 (Straddle) Packer failure	3830	3864	
DST#3 (Straddle) Packer failure	3834	3864	
Run 1780' 4½ csg. for Cedar Hills Disposal			
USE ADDITIONAL SHEETS, IF NECESSARY, TO COMPLETE WELL RECORD.			
Date Received	Signature Operator 8-15-78 Date		