


Section 18 Township 13 Range 17-W

Well No. #1 Polifka

Company Coppinger & Southern

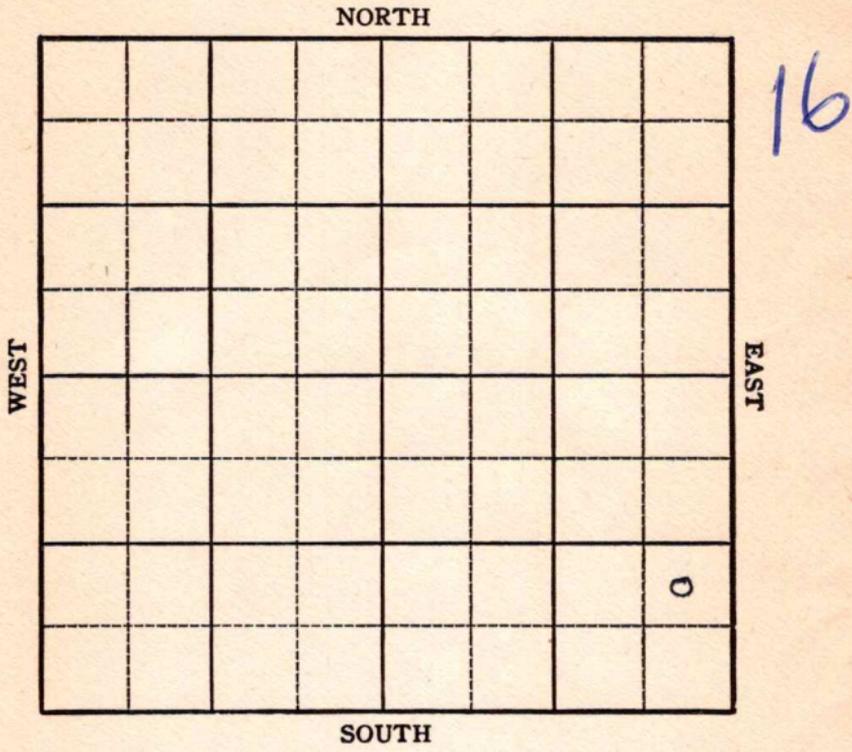

KANSAS

Ellis

Sec. 18 Twp. 13 R. 17W ✓

Well No. #1 Polifka Farm

Coppinger & Southern Company

Coppinger & Southern Contractor

Sugar Loaf


_____ Ft. from N. Line

990 Ft. from S. Line

330 Ft. from E. Line

_____ Ft. from W. Line

NE SE SE

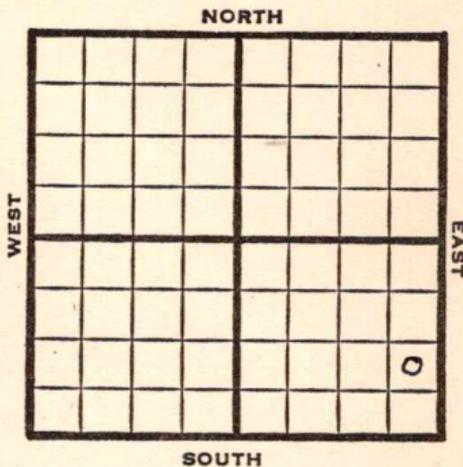

1950

Elev 2097

REPORT

5/10

Rig up

7/5

8" @ 253

Anhy 1295-1347

Lans 3365

SO 3457-68 TD

5" @ 3457

4000 acid

Comp 559 hpd

TD 3468

Completed

COMPLETED

Map No. _____ Sec. 18 Twp. 13 R. 17W

Well No. 1 Polifka

Coppinger & Southern Company

Coppinger & Southern Contractor

NE SE SE

SECTION PLAT

_____ Ft. from N. Line

990 Ft. from S. Line

330 Ft. from E. Line

_____ Ft. from W. Line

			o

FIRST REPORT

Ellis

Location _____

Rig up X

Drilling and Remarks:

RECORD

Cased _____ in., _____ ft.

Sand _____

Gas _____

Oil _____

Total Depth _____

PRODUCTION

1st 24 hrs. Nat. _____

1st 24 hrs. after shot _____

Gas _____ Cu. Ft.

Dry Hole _____

Abandoned _____

Date

MAY 10 1950

19

J. E. TYRA

Scout

Kansas

Map No. _____ Sec. 18 Twp. 13 R. 17W

Well No. 1 Polifka

Coppinger & Southern Company

Contractor

NE SE SE


E1. 2097
SECTION PLAT

_____ Ft. from N. Line

990 Ft. from S. Line

330 Ft. from E. Line

_____ Ft. from W. Line

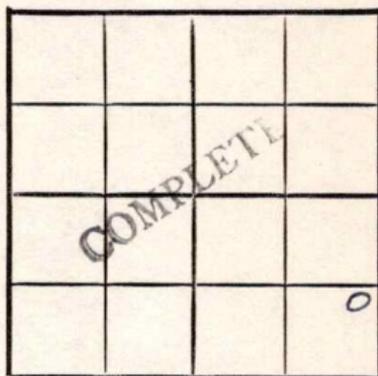

Ellis County

Location _____

Rig up _____

Drilling and Remarks:

8" @ 253

Anhy 1295-1347

Lans. 3365

SO 3457-68 TD

5" @ 3457

4000 acid

Comp. 559 bopd

RECORD

Cased _____ in., _____ ft.

Sand _____

Gas _____

Oil _____

Total Depth 3468

PRODUCTION

1st 24 hrs. Nat. _____

1st 24 hrs. after shot _____

Gas _____ Cu. Ft.

Dry Hole _____

Abandoned _____

Date

JUL 5 1950 19

J. E. TYRA Scout