


Section 26 Township 17 Range 13W

Well No. #1 Reif

Company D.R. Lauck

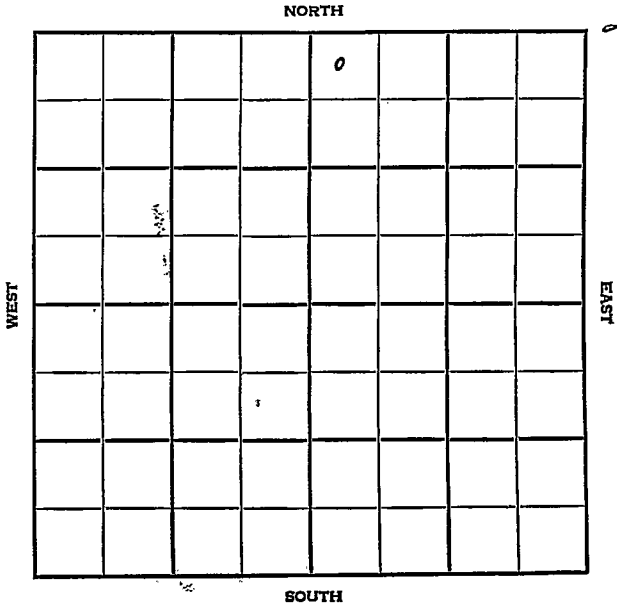

Barton KANSAS

SEC.	TWP.	R.
26	17	13W

WELL NO. 1 Reif FARM

COMPANY

CONTRACTOR D. R. Lauck


Co. Tools  
N. Krug Pool

330 Ft. from N. Line

\_\_\_\_\_ Ft. from S. Line

\_\_\_\_\_ Ft. from E. Line

490 Ft. from W. Line

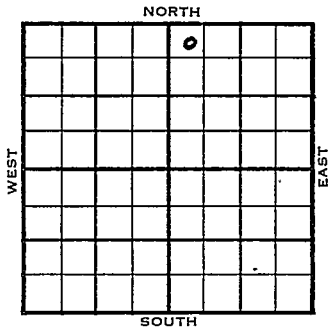

NW NW NE

1954	ELEVATION 1842'	REPORT
------	--------------------	--------

11/23 Spud 11-21-54  
8" @ 232', WOC

12/8 Spud 11-21-54  
D & A  
TD 3400'  
8" @ 232'  
Heeb 3011'; Tor. 3029', Br. Lime 3099'  
K.C. 3112', Cong 3365',  
TD 3400'  
D & A

**ABANDONED**



