


Barton

KANSAS

SECTION 28 TOWNSHIP 17 RANGE 13W

WELL NO. #1 Klug "B"

COMPANY Petroleum Inc.

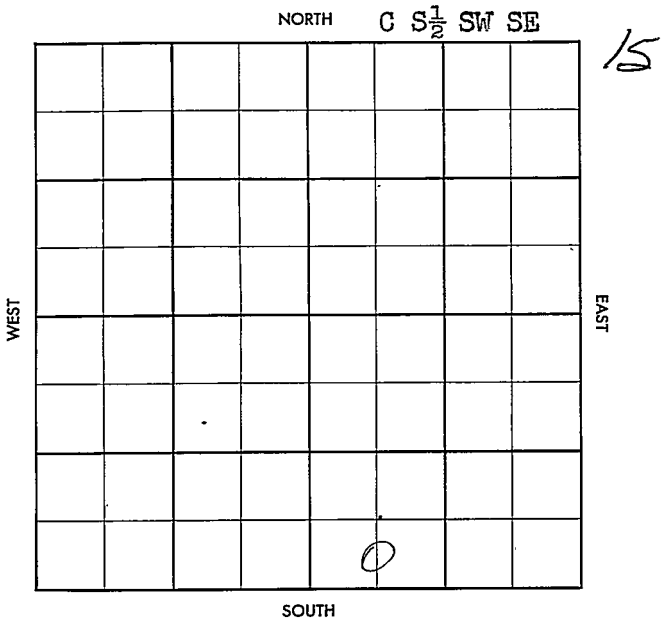

County Barton Elev. \_\_\_\_\_  
 Sec. 28 Twp. 17 Rge. 13W  
 Company Petroleum Inc.  
 FarmName Klug #111 No. 1

TOPS	DEPTH	LOG	DATUM
Anh.	826		
TP.			
H.			
Tr.			
Dg.			
Bl.			
L.			
K.C.			
B.K.C.			
Ce.			
C.			
M.			
M.			
K.			
Mz.			
Mo.			
V.			
S.			
S.			
A.			
R.			
PE.			
G.			
T.D.			

Loc. in Sec. G S $\frac{1}{2}$  SW SE  
 Geol. \_\_\_\_\_  
 Contr. \_\_\_\_\_  
Garvey  
 Pool \_\_\_\_\_  
Klug  

FIRST REPORT	
FEB 6 '57	
0	

Date Comm. 2-2-57  
8" @ 456/250 drilg. 2110

~~111~~

Co.  
 Lse.  
 No.  
 Sec.  
 T.  
 R.

County Barton Elev. 1908  
 Sec. 28 Twp. 17 Rge. 13W  
 Company Petroleum Inc.  
 Farm Name Klug "B" No. 1

TOPS	DEPTH	LOG	DATUM	Loc. in Sec.
Anh.	826			C S $\frac{1}{2}$ SW SE
TP.				
H.	3071			
Tr.	3088			
Dg.	3101			
Bl.	3155			
L.	3172			
N.C.				Geol.
B.K.C.				Contr.
Ce.				Garvey
C.				
M.				Pool
M.				Klug
K.				
Mz.				
Me.				
V.				
S.				
A.	3396			ABANDONED
R.				FEB 13 '57
PE.				
G.				
TD.	3425			0

Date Comm. 2-2-57

8" @ 456/250 drlg. 2110 FEB 13 '57

DST 3157-3200 1hr rec 5'  
 Md BHP 180/20" DST 3192  
 -3240 1hr rec 150' HOE'6CM  
 BHP 100/20" DST 3307-75 OK  
 1hr rec 6' Md BHP 160 DST  
 3396-3408 1hr rec 10' Md BHP  
 920/20" DST 3395-3405 OK  
 1hr rec 35' Md BHP 1000

DST 3405-25 1hr sec 270'  
MSW BHP 840

DST