


SECTION 4 TOWNSHIP 12 RANGE 15W

WELL NO. #1 Eulert

COMPANY Mai Operations

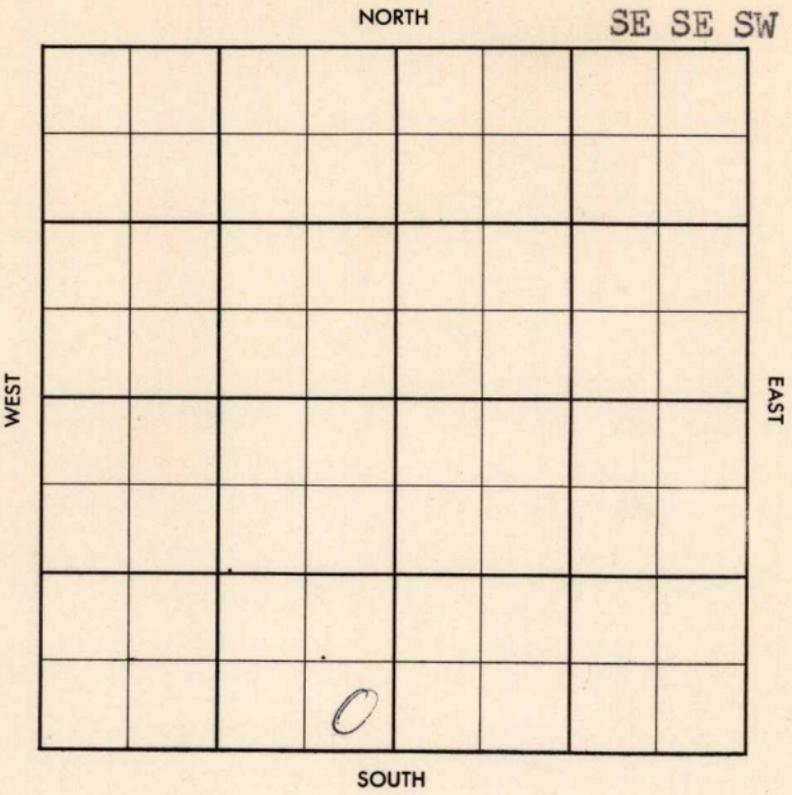



County Russell Elev. _____
 Sec. 4 Twp. 12 Rgs. 15W
 Company Mai Operations
 Farm Name Eulert No. 1

TOPS	DEPTH	LOG	DATUM
Anh.			
TP.			
H.			
Tr.			
Dg.			
Bl.			
L.			
K.C.			
B.K.C.			
Ce.			
C.			
M.			
M.			
K.			
Mz.			
Mq.			
V.			
S.			
S.			
A.			
R.			
PE.			
G.			
T.D.			

Loc. in Sec. SE SE SW
 Geol. Lec Cornell
 Contr. Mast Drlg.
 Pool _____
 JUN 12 57
 FIRST REPORT
 0

Date Comm. H. G. Kaiser - (DHM)
 Location _____

Co.
 Lse.
 No.
 Sec.
 T.
 R.

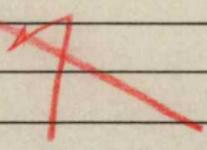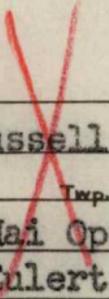

Co.

Lse

No.

Sec.

T.

R.

County Russell Elev. 1687
 Sec. 4 Twp. 12 Rge. 15W
 Company Mai Operations
 Farm Name Eulert No. 1

	TOPS	DEPTH	LOG	DATUM
Anh.		748		
Tp.	<u>How</u>	2540		
H.	<u>TP</u>	2571		
Tr.	<u>H6</u>	2790		
Dg.	<u>Dodge</u>	2809		
Bl.	<u>D9</u>	2824		
L.		2841		
K.C.				
B.K.C.				
Ce.				
C.	<u>shly</u>	3120		
M.	<u>cherty c9</u>	3152		
M.				
K.				
Mz.				
Mq.				
V.				
S.				
S.				
A.				
R.				
PE.				
G.				
T.D.		3180		

Loc. in Sec. SE SE SW
 Geol. Lee Cornell
 Contr. Mast Drllg.
 Pool

ABANDONED
 JUL 31 '57
 0

Date Comm. H. G. Kaiser - (DHM)

Location JUN 19 '57 ✓ JUN 25 '57 JUL 3 '57

MIR JUL 10 '57 ✓ 7-2-57 858
755/375 2580 JUL 17 '57 DIT
2752-80 1hr rec 25' Md BHP
1160/30 DIT 2796-2816 1hr
rec 20' Md 700/30" DIT 2843
-55 1hr 360' 6hr rec 30' Md
+850 335/30" DIT 2860-77 1hr
rec 40' Md BHP 550/30" 5 1/2 3070

PF 2868-72 $\frac{1}{2}$ \$ 6 BWph + SC.
 oil PB 2860 12/2842-46
 12/2848-52 $\frac{1}{2}$ \$ 14 BFph
 + SC. oil 24 hrs) JUL 31 57 PB 2830
 24/2811-15 $\frac{1}{2}$ \$ 10 BWph

DEA