


Section 29 Township 17 Range 13 W

Well No. #1 Stoskopf

Company J. F. Darby Oil

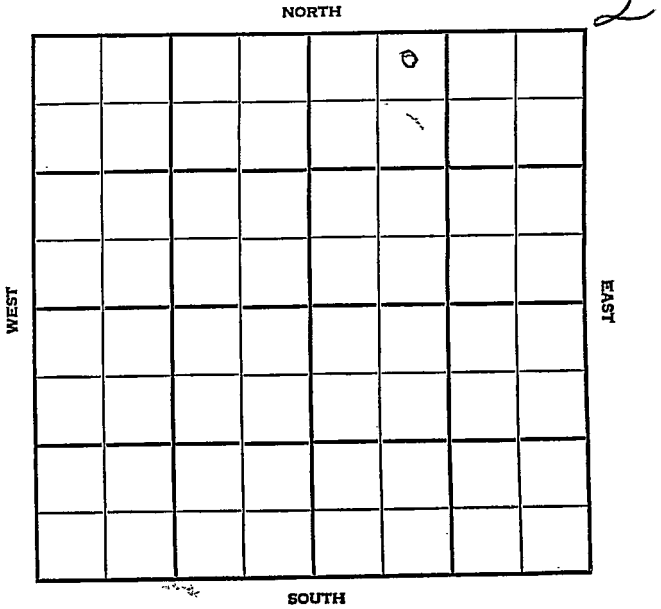

Barton

KANSAS

SEC. 29.	TWP. -- 17	R. 13W
-------------	---------------	-----------

WELL NO.

#1 Stoskopf

FARM

COMPANY

J.F. Darby Oil

CONTRACTOR

Iron Drlg.


_____ Ft. from N. Line

_____ Ft. from S. Line

_____ Ft. from E. Line

_____ Ft. from W. Line

NE NW NE

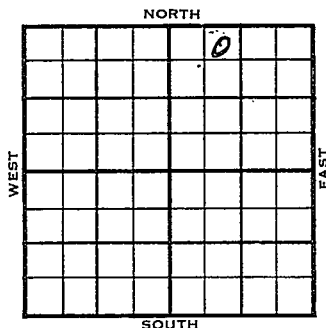

1956	ELEVATION	REPORT
	1898	

3-9 Comm. 3-5656

~~###~~

3-21 8 5/8" @ 200/125
 DST 3190-3221 op 1 hr. rec. 30' vsocm
 50/20"
 DST 3272-3305 op 1 hr. rec. 15' mud,
 0#
 DST 3364-75 op 1 hr. rec. 15' so&gcm
 420/20"
 D & A
 H. 3066
 BL 3147
 L. 3160
 A. 3368
 TD 3400'

ABANDONED

County Barton Elev. _____
 Sec. 29 Twp. 17 Rge. 13W
 Company J. F. Darby Oil
 Farm Name Stoskopf No. 1

TOPS	DEPTH	LOG	DATUM
Anh.			
Tr.			
H.			
Tr.			
Dg.			
Bl.			
L.			
K.C.			
B.K.C.			
Ce.			
C.			
M.			
M.			
K.			
Mz.			
Me.			
V.			
S.			
S.			
A.			
R.			
PE.			
G.			
T.D.			

Loc. in Sec. NE NW NE
 Geol. _____
 Contr. Iron Drlg.
 Pool _____

MAR 7 1956
 FIRST REPORT

Date Comm. 3-5-56

[Handwritten signature]

Co.
 Sec.
 T.
 R.

County Barton Elev. 1898
 Sec. 29 Twp. 17 Rge. 13W
 Company J. F. Darby Oil
 FarmName Stoskopf No. 1

TOPS	DEPTH	LOG	DATUM	Loc. in Sec.
Anh.				NE NW NE
Tr.				
H.	<u>3066</u>			
Tr.				
Dg.				
Bl.	<u>3147</u>			
L.	<u>3166</u>		<u>1262</u>	Geol.
K.C.				Contr.
B.K.C.				Iron Drlg.
Ce.				
C.				Pool
M.				
M.				
K.				
Mz.				
Me.				
V.				
S.				
S.				
A.	<u>3368</u>		<u>1470</u>	
R.				
Pe.				ABANDONED
G.				
T.D.	<u>3400</u>			

Date Comm. 3-5-56 MAR 21 1956

8 5/8" @ 200/125 DST 3190-3221

open 1 hr. rec. 30' vsocm 50/20"

DST 3272-3305 open 1 hr. rec. 15' mud

O# DST 3364-75 open 1 hr. rec.

15' so & gcm 420/20"

D & A