


Section 4 Township 12 Range 15W

Well No. 1 Eulert

Company Mid-States & Gabbert-Jones

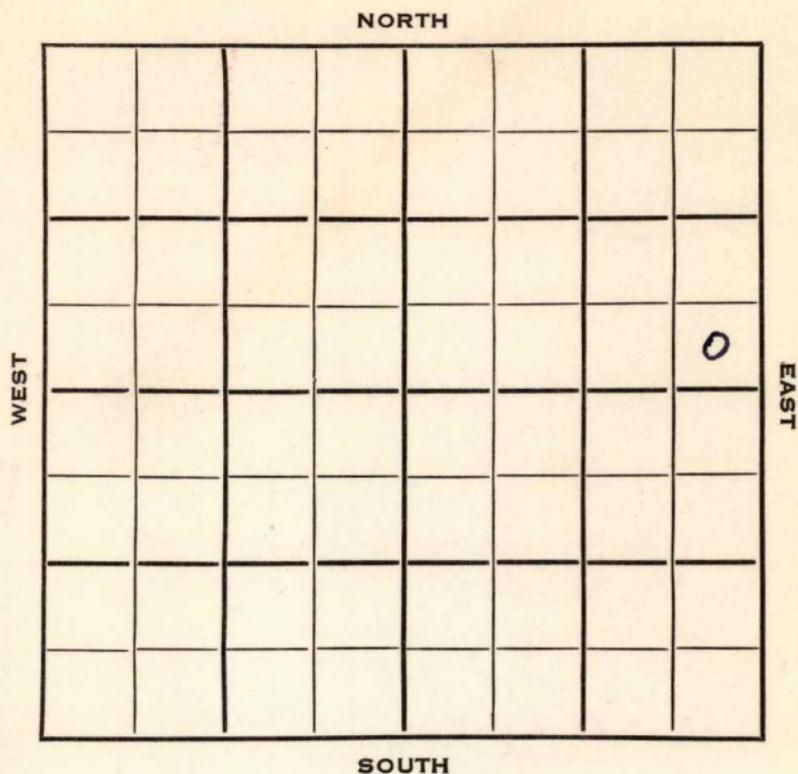

Russell

KANSAS

SEC.	4	TWP.	12	R.	15W
------	---	------	----	----	-----

WELL NO.

#1 Eulert

FARM

COMPANY

Mid-States & Gabbert-Jones

CONTRACTOR

Gabbert-Jones

Wildcat

Ft. from N. Line


330

Ft. from S. Line

330

Ft. from E. Line

Ft. from W. Line

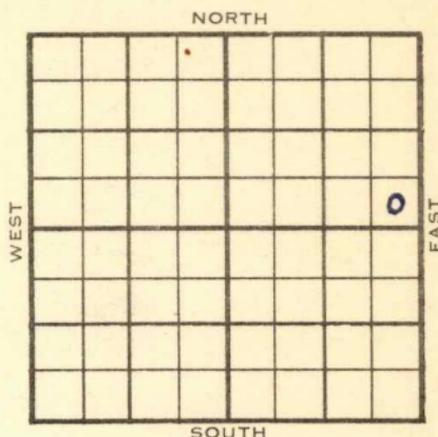

SE SE NE

1953

ELEVATION

1721'

REPORT

9/16

Location

9/23

"

10/14

8" @ 789'

Anhy 784'

Drlg. 2796'

10/21

Spud 10-5-53

D&A

TD 3245

8" @ 789

Anhy 784, Top 2582,

DST 2783-2820, opn 1 hr., rec. 135'

sw,

DST 2888-2942, opn 1 hr., rec. 90'

mud, & sw, 465#

Heeb 2833, Tor 2853, Lans 2884,

Cong 3164

DST 3171-3200, opn 1/2 hrs., rec. 15'

mud, Off

Arb. 3215

TD 3245

D&A

ABANDONED

