

Russell


KANSAS

FORM 51 IOM 12-46 PETROL

Section 5 Township 12 Range 15W

Well No. 1 Brummitt

Company Farris & B & R

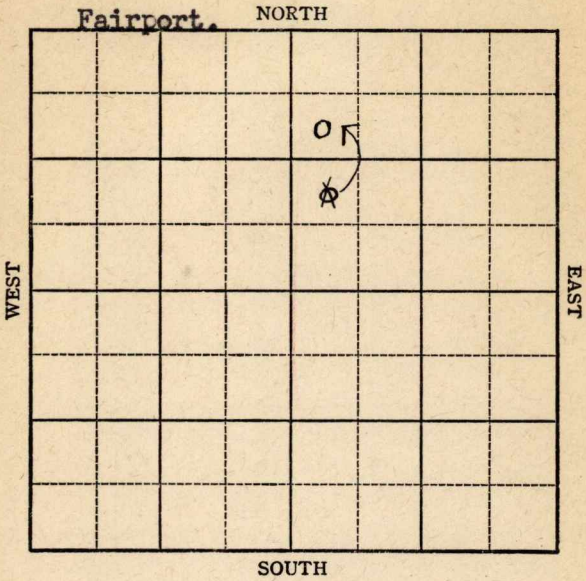

Sec. 5

Twp.

R.

1 Brummitt


Well No. _____ Farm

Farris & B. & R

Company

Fairport

NORTH

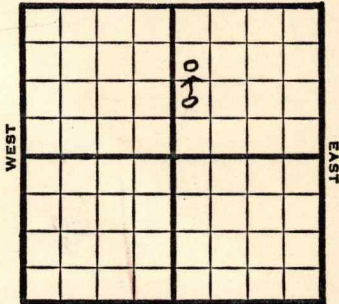

990 Ft. from N. Line

~~900~~ Ft. from S. Line

_____ Ft. from E. Line

330 Ft. from W. Line

~~NW SW NE~~ SW NW NE

1947

Elev. 1744' REPORT

4/30

8" @ 587
Anhy 790
Topeka 2600
Drlg. 2681

5/7

SO 2580-94, 2770-88
D Dodge 2837'
Lans 2861'
SO 2889-94, 3068-81
Cong 3170
Gorham 3183-87
TD 3187'
8" @ 3183

5/13

" "

5/20

" "

5/27

TD 3187'

6/3

" "

6/11

Gorham 3183'
5" @ 3183'
Pump 75 Pot
Gr. 36.0
TD 3187'

COMPLETED

Map No. 72 Sec. 5 Twp. 12 R. 15W

Well No. 1 Brummitt

Farris & B & R Company

CORRECTION

Contractor

SW NW NE

SECTION PLAT

990 Ft. from N. Line

_____ Ft. from S. Line

_____ Ft. from E. Line

330 Ft. from W. Line

		05	
		25	

Russell County

RECORD

Location _____

Cased _____ in., _____ ft.

Rig up _____

Sand _____

Drilling and Remarks:

Gas _____

Oil _____

Reported
NW SW NE

Total Depth _____

PRODUCTION

1st 24 hrs. Nat. _____

1st 24 hrs. after shot _____

Gas _____ Cu. Ft.

Dry Hole _____

Abandoned _____

Date

MAY 14 1947

19

S. J. LEWIS

Scout

Map No. 72 Sec. 5 Twp. 212 R. 15W

Well No. 1 Brummitt

Farris & B & R Company

COMPLETE Contractor

SW NW NE

E. 1744
SECTION PLAT

990 Ft. from N. Line

_____ Ft. from S. Line

_____ Ft. from E. Line

330 Ft. from W. Line

		o	

Russell County

RECORD

Location _____

Cased _____ in., _____ ft.

Rig up _____

Sand _____

Drilling and Remarks:

Gas _____

See ham 8/83
5' 03/83

Oil _____

Total Depth 3187

Pump 25 8/83

PRODUCTION

1st 24 hrs. Nat. _____

1st 24 hrs. after shot _____

Gas _____ Cu. Ft.

Dry Hole _____

Abandoned _____

36° 44'

Date

JUN 11 1947 19

S. J. LEWIS Scout