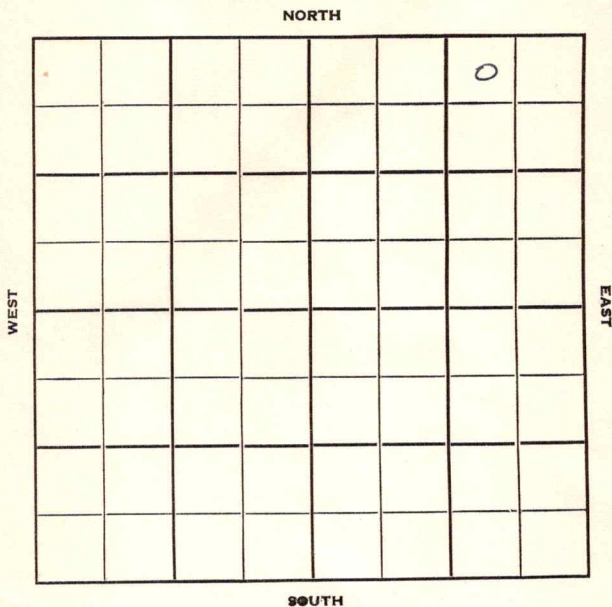


Section 19 Township 13 Range 17WWell No. #1 StaabCompany Dwight Sutherland et al

Ellis ~~KANSAS~~

Sec. 19 Twp. 13 R. 17W ✓

Well No. #1 Staab Farm

Dwight Sutherland et al Company

Glen Nye - Contr. Contractor

Catherine Pool


330' Ft. from N. Line

_____ Ft. from S. Line


990' Ft. from E. Line

_____ Ft. from W. Line

NW NE NE

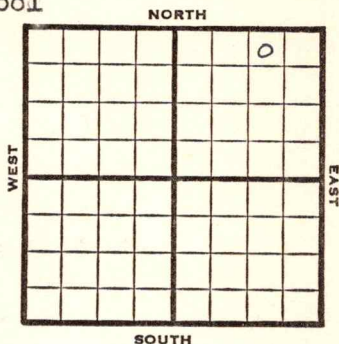


1950	Elev. 2118' REPORT
11/29	Spud 11-24-50 8" @ 264'
12/13	Drlg. 1700' Spd 11-24-50 D&A TD 3530 8" @ 264' Anhy 1338-70 Lans. 3410' DST 3445-85 opn ½ hr Rec. 50' mud BHP 435# DST 3505-13 opn 1 hr Rec. 55' mud & sw TD 3530 D&A ABANDONED

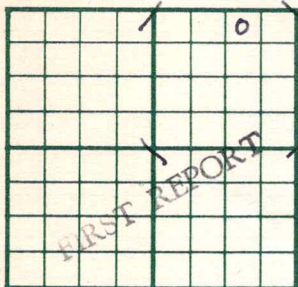County Ellis State KansasSec. 19 (Blk.) 13 (Sur.) 17W Map No.Operator Dwight Sutherland et al.Well No. 1 Farm StaabElev. Location NW NE NE330 Ft. From N Line NE990 Ft. From E Line Quarter1st. Report NOV 29 1950

Completion

Remarks

Glen Nye - Contr.Spudding Date 11-24-50Drlg. Data Catherine Pool8" @ 264 drlg. 1700

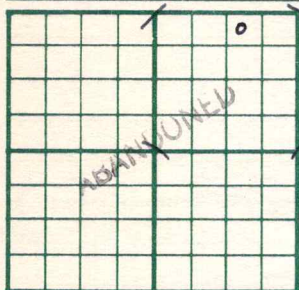County Ellis State KansasSec. 19 (Blk.
Twp.) 13 (Sur.
Rge.) 17W Map No.Operator Dwight Sutherland et al.Well No. 1 Farm StaabElev. 2118 Location NW NE NE330 Ft. From N Line NE990 Ft. From E Line Quarter

1st. Report

Completion DEC 13 1950Remarks Catherine PoolGlenn Nye - Contr.Spudding Date 11-24-50Drlg. Data D & A TD 35308" @ 264 Anhy 1338-70 Lans. 3410DST 3445-85 open $\frac{1}{2}$ hr. Rec. 50' mudBHP 435# DST 3505-13 open 1 hr.Rec. 55' mud & sw TD 3530D & A