


Map No. Kansas Sec. 5 Twp. 12 R. 15^w

Well No. 1 Kollman Farm

~~Cassoday~~ Company

H. Patton NORTH

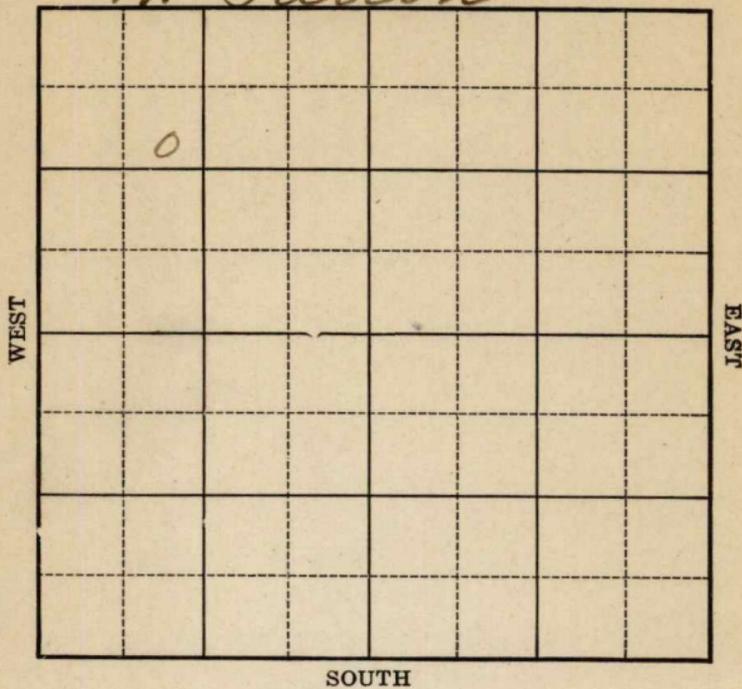

Location _____

Drilling Remarks _____

Rig Up _____

Drilling Remarks _____

RECORD

Cased _____ in. _____ ft.

Sand _____

Gas _____

Oil _____

Total Depth _____

PRODUCTION

1st 24 hrs. Nat. _____

1st 24 hrs. after shot _____

Gas _____ cu. ft.

Dry Hole _____

Abandoned _____

Russell Co


KANSAS

Map No. _____ Sec. 6 Twp. 12 R. 15 W

Well No. 1 Hallman Farm _____

~~Cassaday Oil~~ Company
H. Patton

NORTH

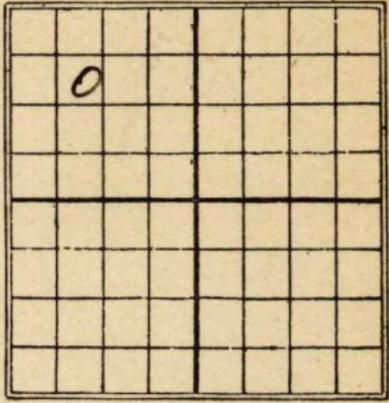

990 Ft. from N. Line

_____ Ft. from S. Line

_____ Ft. from E. Line

990 Ft. from W. Line

1925

Date

REPORT

8/27 R.O.G.

9/19 600'

~~9/30~~

9/30 27g 2280

10/28 sand 2804 to 2810
swabbing 2 lbs
per hr.

Map No. **KANSAS** Sec. 5 Twp. 12 R. 15W

Well No. 1 Kollman

Cassoday Company

Contractor

FIRST REPORT

990 Ft. from N. Line

_____ Ft. from S. Line

_____ Ft. from E. Line

990 Ft. from W. Line

SECTION PLAT

0			

Location _____

Rig up _____

Drilling and Remarks:

R.O.G.

RECORD

Cased _____ in., _____ ft.

Sand _____

Gas _____

Oil _____

Total Depth _____

PRODUCTION

1st 24 hrs. Nat. _____

1st 24 hrs. after shot _____

Gas _____ Cu. Ft.

Dry Hole _____

Abandoned _____

Date

AUG 20 1925

S. J. LEWIS

Scout

Russell

Map No. KANSAS Sec. 5 Twp. 12 R. 15 W

Well No. 1 Kollman

H. Patton Company

Contractor

*11/6/20
map*

SECTION PLAT

990 Ft. from N. Line

_____ Ft. from S. Line

_____ Ft. from E. Line

990 Ft. from W. Line

0			

Correction

Location _____

Rig up _____

Drilling and Remarks:

*This was reported
Cass today
should be
H. Patton*

RECORD

Cased _____ in., _____ ft.

Sand _____

Gas _____

Oil _____

Total Depth _____

PRODUCTION

1st 24 hrs. Nat. _____

1st 24 hrs. after shot _____

Gas _____ Cu. Ft.

Dry Hole _____

Abandoned _____

Date

SEP 30 1925

S. J. LEWIS

Scout

No Map

Map No. KANSAS Sec. 5 Twp. 12 R. 15 W

Well No. 1 Kollman

H. Patton Company

Contractor

SECTION PLAT

990 Ft. from N. Line

_____ Ft. from S. Line

_____ Ft. from E. Line

990 Ft. from W. Line

0			

COMPLETED

Location _____

Rig up _____

Drilling and Remarks:

Sand 2804 to 2810

Swabbing 28 ft per hr

RECORD

Cased _____ in., _____ ft.

Sand _____

Gas _____

Oil _____

Total Depth _____

PRODUCTION

1st 24 hrs. Nat. _____

1st 24 hrs. after shot _____

Gas _____ Cu. Ft.

Dry Hole _____

Abandoned _____

Date

OCT 28 1925

192

S. J. LEWIS

Scout